


T.8S. R.46E. W.M.

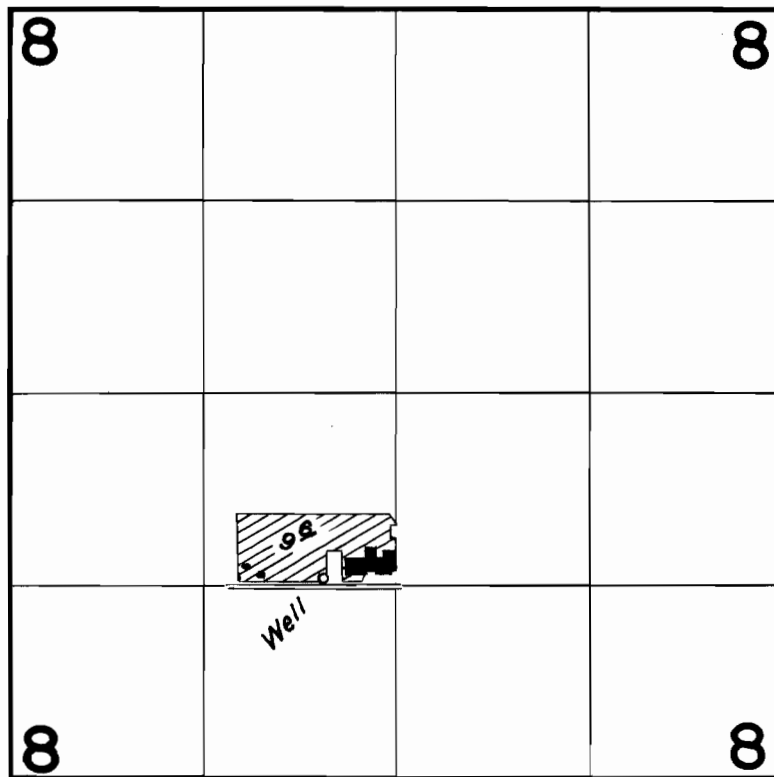

FINAL PROOF SURVEY
UNDER

Application No. G-2596... Permit No. G-2419...
IN NAME OF

SCHOOL DISTRICT #61 BAKER, COUNTY, OREGON

Surveyed Nov. 10, 1964., by R. Jackson.....