


T.14 S.R. 5W.W.M.

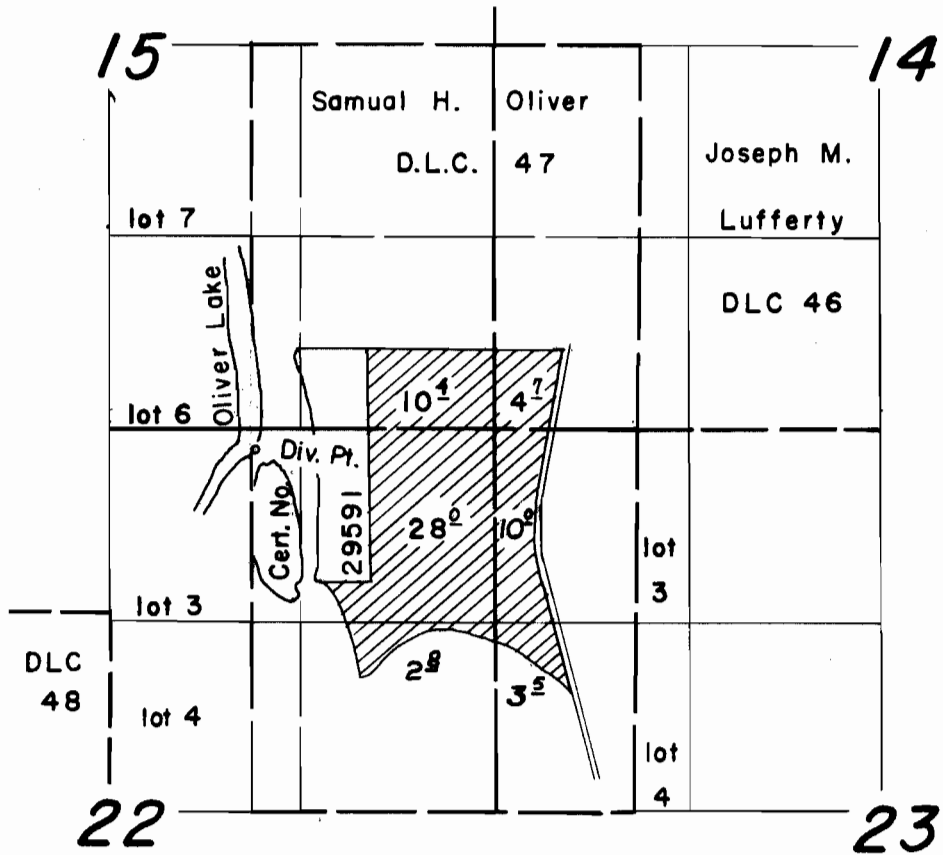

FINAL PROOF SURVEY
UNDER

Application No. 38903 Permit No. 28959
IN NAME OF

Arnold Eberlein

Surveyed Aug. 5, 1964, by F. Siegmund