


T. 13 S. R. 5 W. W. M

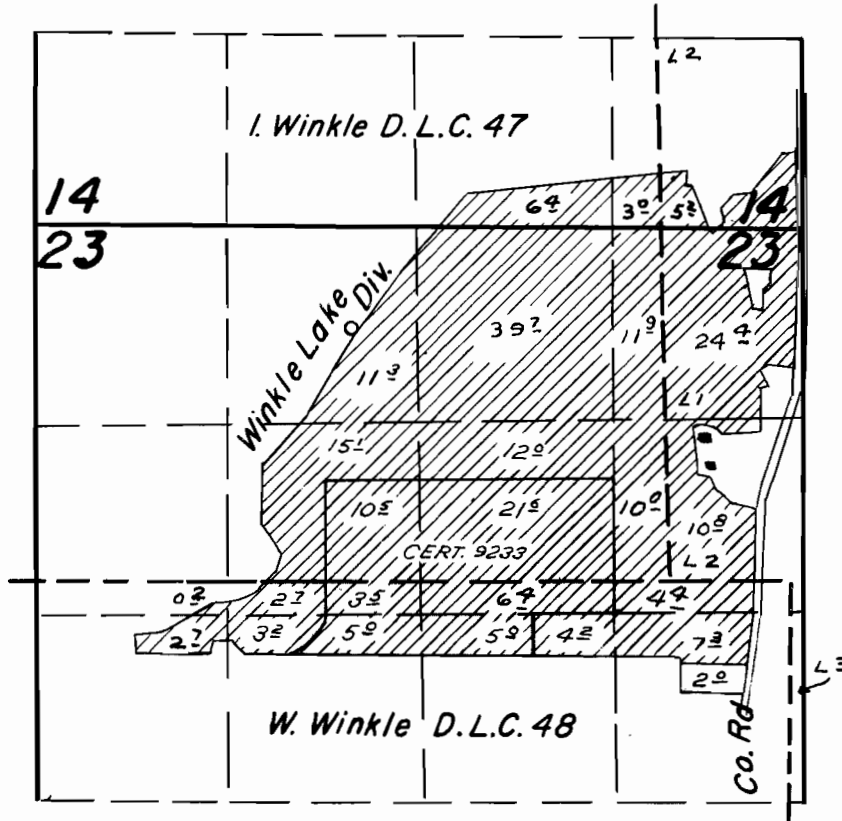

FINAL PROOF SURVEY  
UNDER

Application No. 35034 Permit No. 27476  
IN NAME OF

**C.E. Miller**

Surveyed Aug. 7, 1964, by *Roy L. Sigmund*