


T.16S. R.23E. W.M.

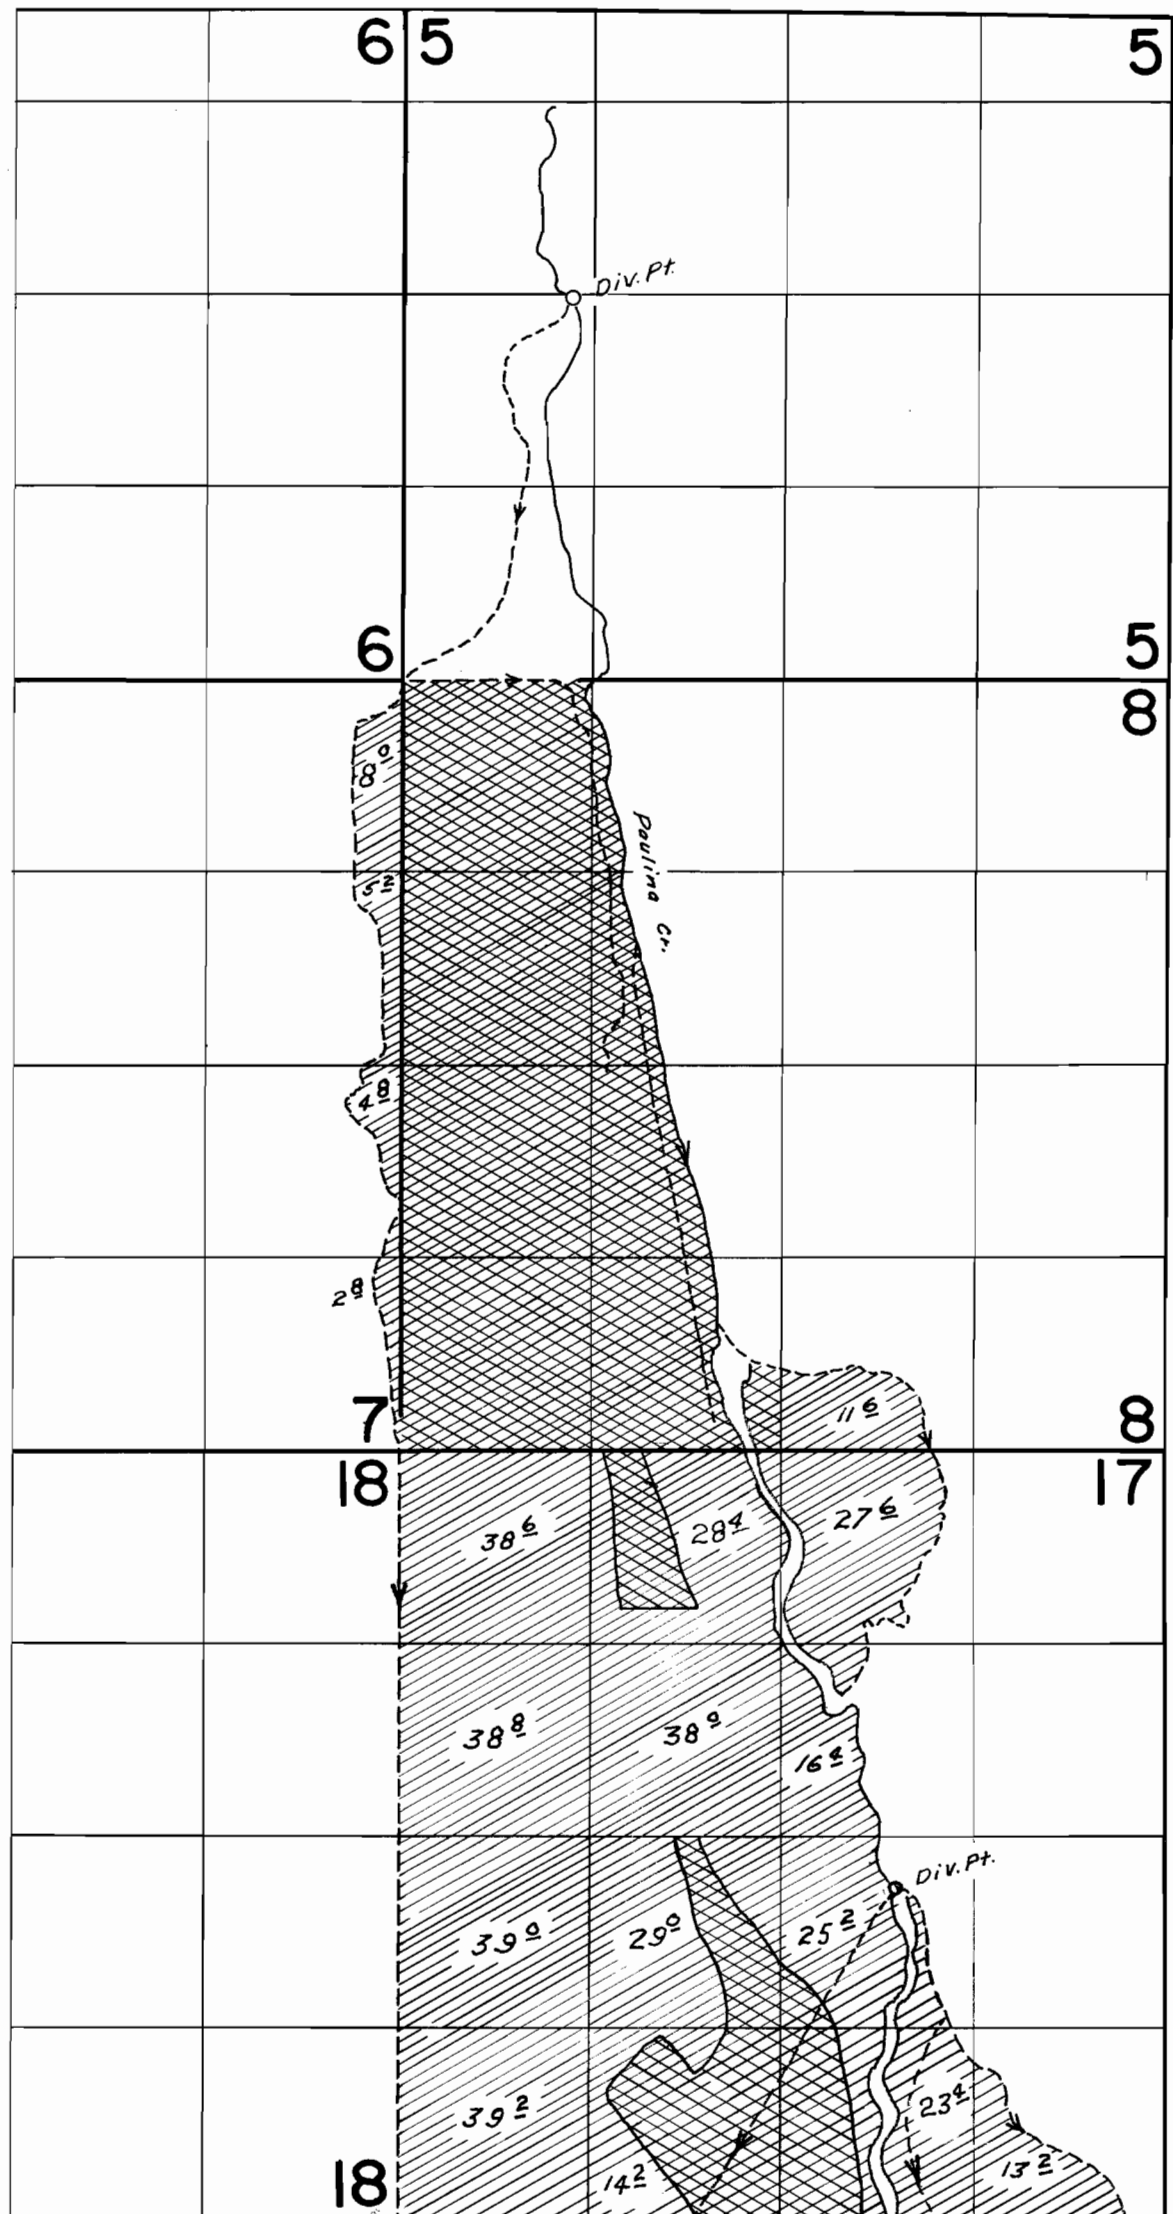

Double hachured area is irrigated  
under certificates 535 & 686

Single hachured area is  
application 18470

**FINAL PROOF SURVEY**  
Under  
Transfer No. M-18  
Application No. 18470 Permit No. 14081

in name of

**ROGER HUDSPETH**

Surveyed Oct. 6, 1964 By *C.J. Gardner*