


T.18S. R.20E. W.M.

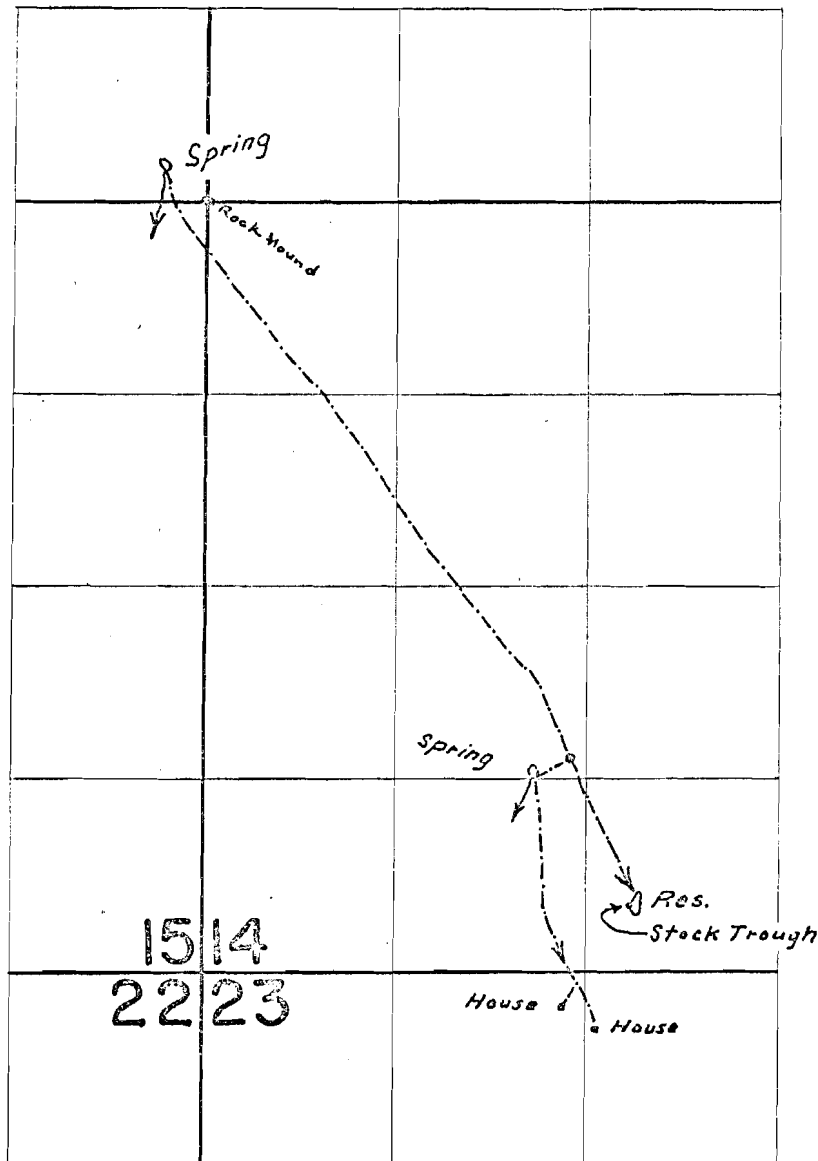

FINAL PROOF SURVEY UNDER

38018 28335
Application No. R-38017 Permit No. R-3144
IN NAME OF

WALT B. SCHROCK

Surveyed Oct. 2, 1964, by R. Jackson

PK 28335
1964-F
C33