


T.26S.R.4W.W.M.

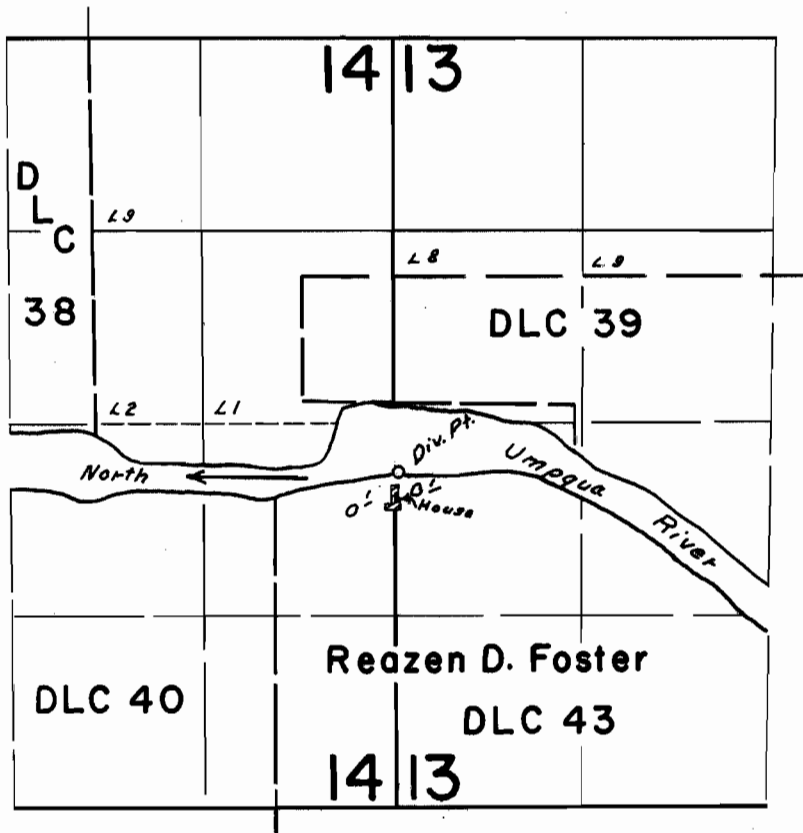

FINAL PROOF SURVEY
UNDER

Application No. 37471 Permit No. 27943
IN NAME OF

DAVID WELBORN

Surveyed July 29, 1964, by C.J. Gardner