


T. 33 S. R. 32 E. W.M.

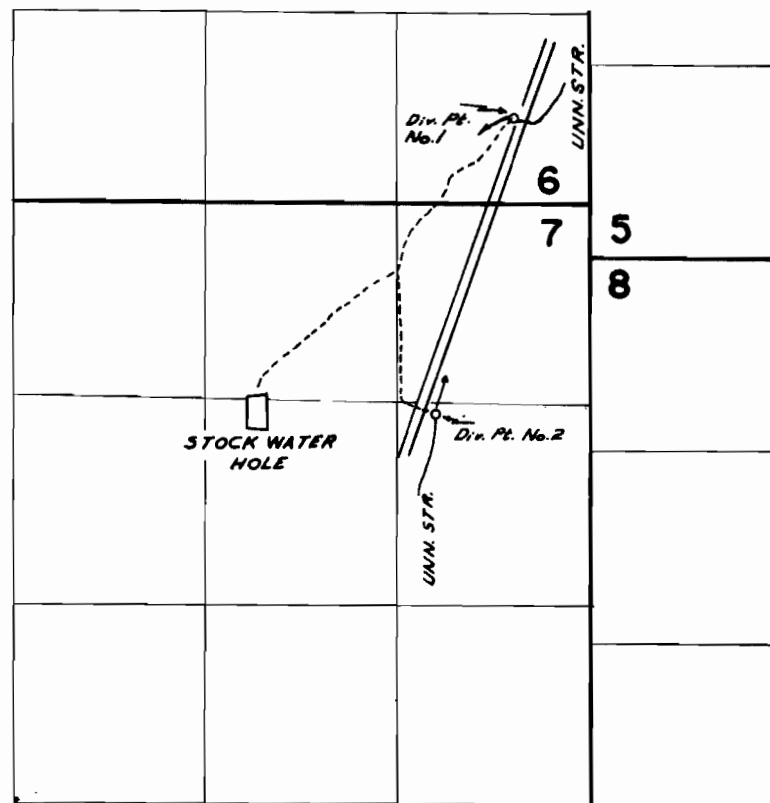

Div. Pt. No. 1 LOCATED 9840 Ft. S. & 3180 Ft. W. BOTH FROM N. 1/4 Cor.
Div. Pt. No. 2 LOCATED 11,855 Ft. S. & 3825 Ft. W. SEC. 32 T. 32 S. R. 32 E.

FINAL PROOF SURVEY
UNDER

Application No. 22104 Permit No. 17420
IN NAME OF

ALLIED LAND & LIVESTOCK CO.

Surveyed AUG. 20 1963, by T. LAUER