


T.39S.R.2W.W.M.

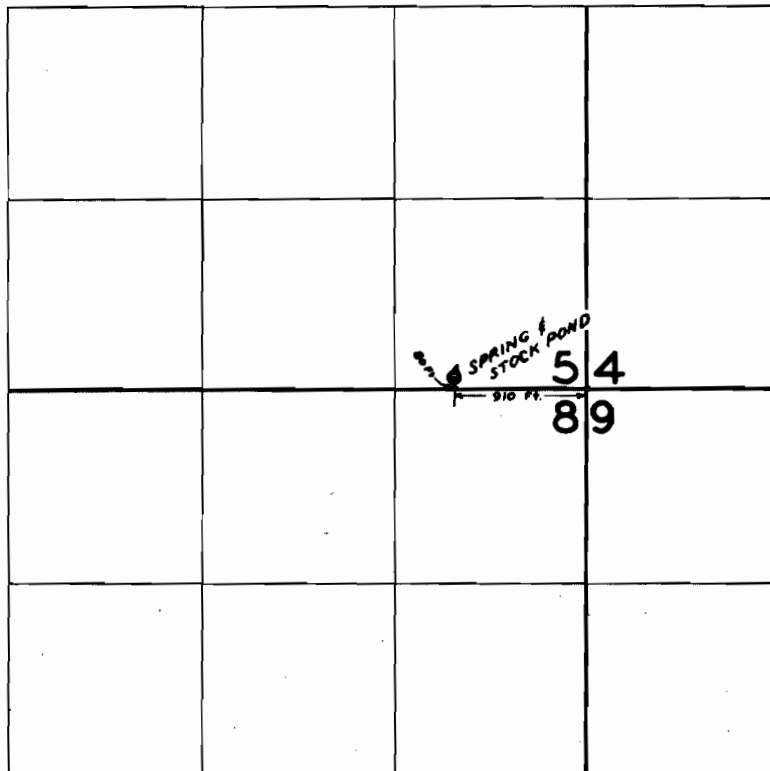

FINAL PROOF SURVEY
UNDER

Application No. 34956 Permit No. 27415
IN NAME OF

J. BUFORD WELS

Surveyed JUL. 1 1965, by C. GARDNER