


T.34S.R.1W.W.M.

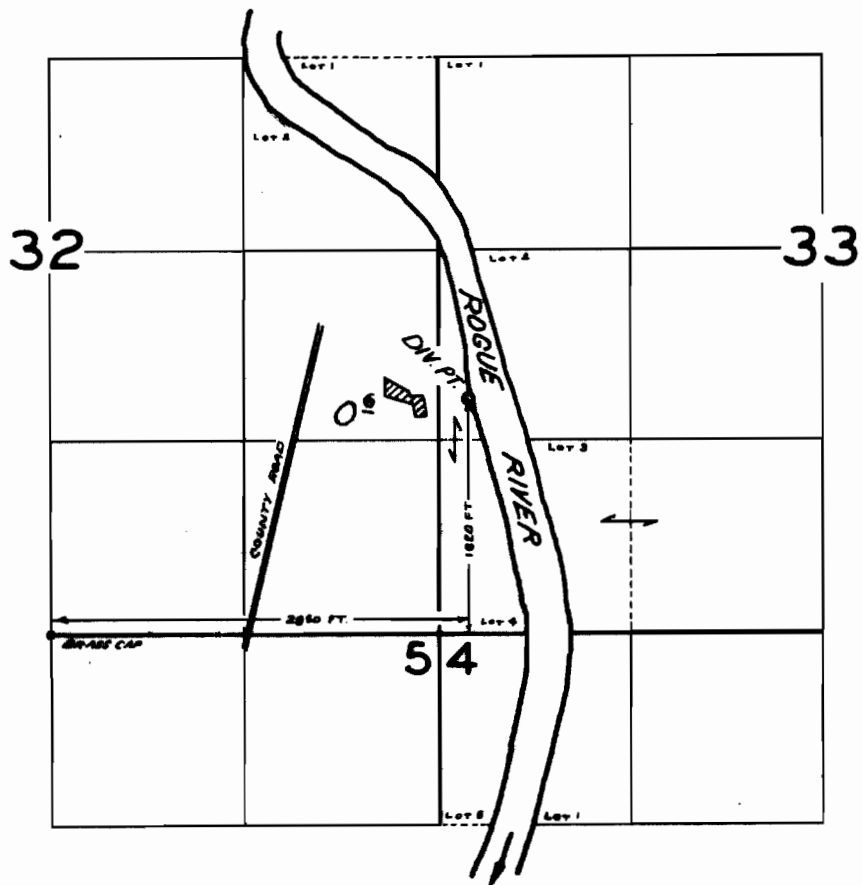

FINAL PROOF SURVEY
UNDER

Application No. 39197 Permit No. 26943

IN NAME OF

LLOYD WINKLEBY, JR.

Surveyed JUL 14, 1965, by C. GARDNER