


T. 37 S. R. 7 W. W. M.

SECTION 1

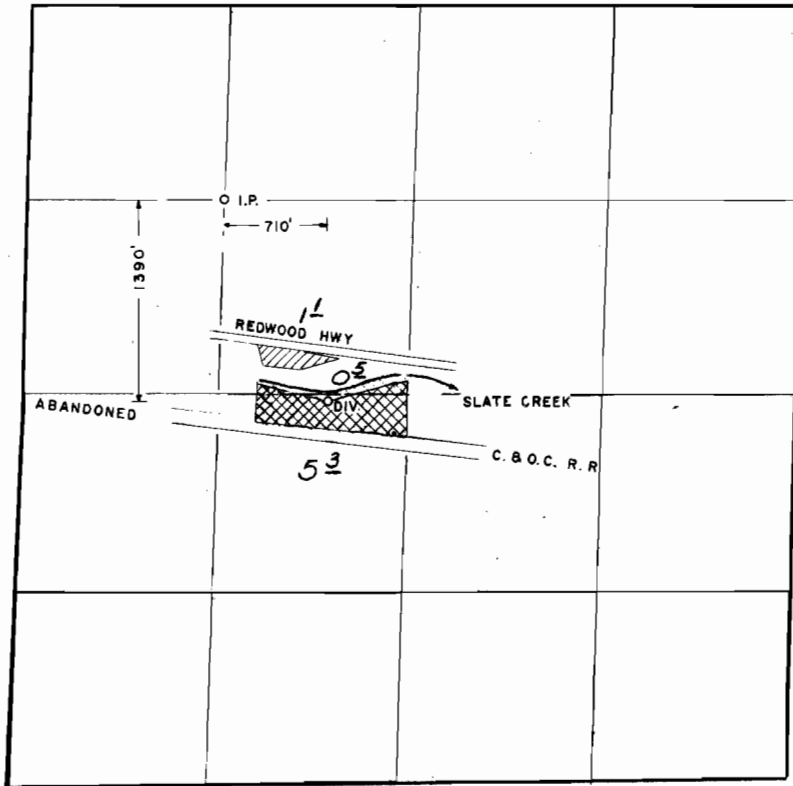

PERMIT 17742
CERTIFICATE 20200



PERMIT 29352

FINAL PROOF SURVEY UNDER

Application No. 39335 Permit No. 29352
IN NAME OF

JOE L. & ELIZABETH A. ASHBY

Surveyed APRIL 2 1965, by R. B. STEIMER