


T.23S.R.10E.W.M.

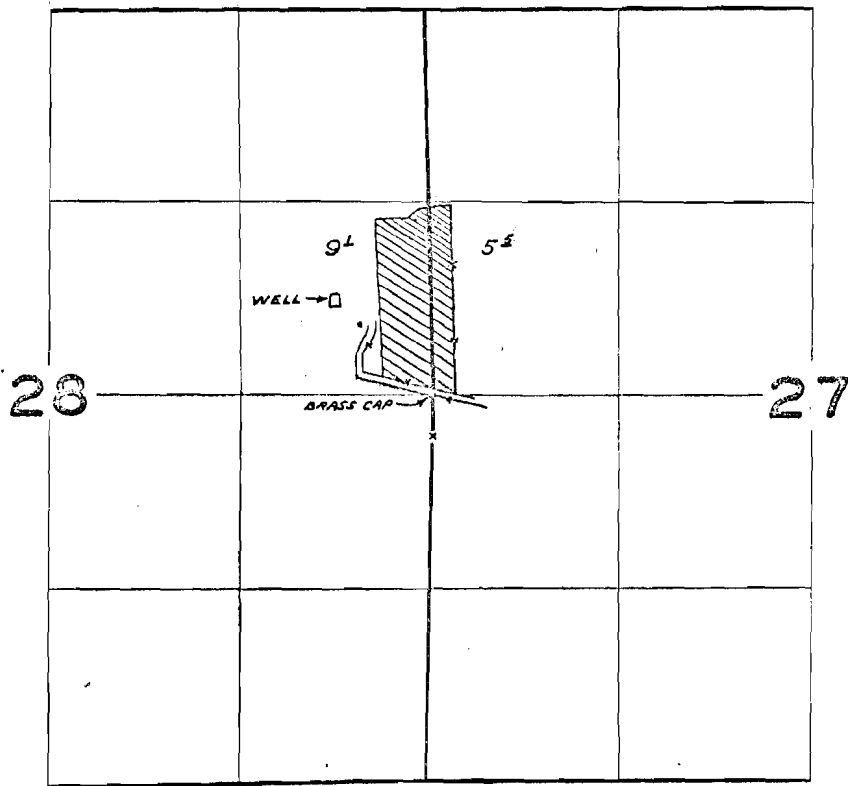

FINAL PROOF SURVEY  
UNDER

Application No. G-1977 Permit No. G-1271  
IN NAME OF

R. S. HAWTHORNE

Surveyed JUN. 18. 1964, by R. JACKSON

g-1271  
1964-C 208