


T. 39S. R. 11 & 12 E. W. M.

East River Wells

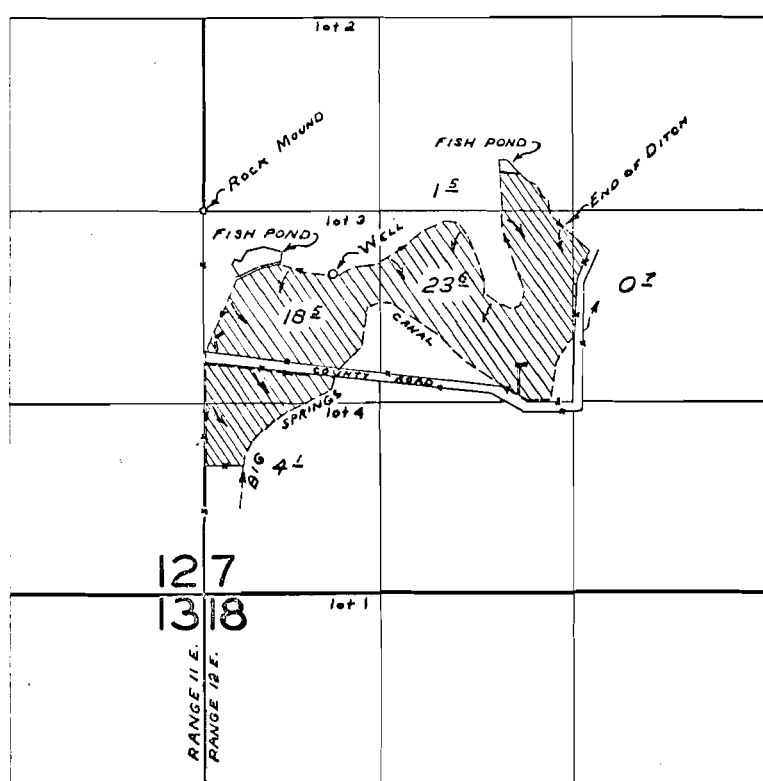

FINAL PROOF SURVEY UNDER

Application No. G-104 Permit No. G-108
IN NAME OF

CECIL C. HALEY

Surveyed JUL 21 1964, by R. JACKSON