


T.36S.R.13&14E.W.M.

A. B. Sprague Co. & Moe

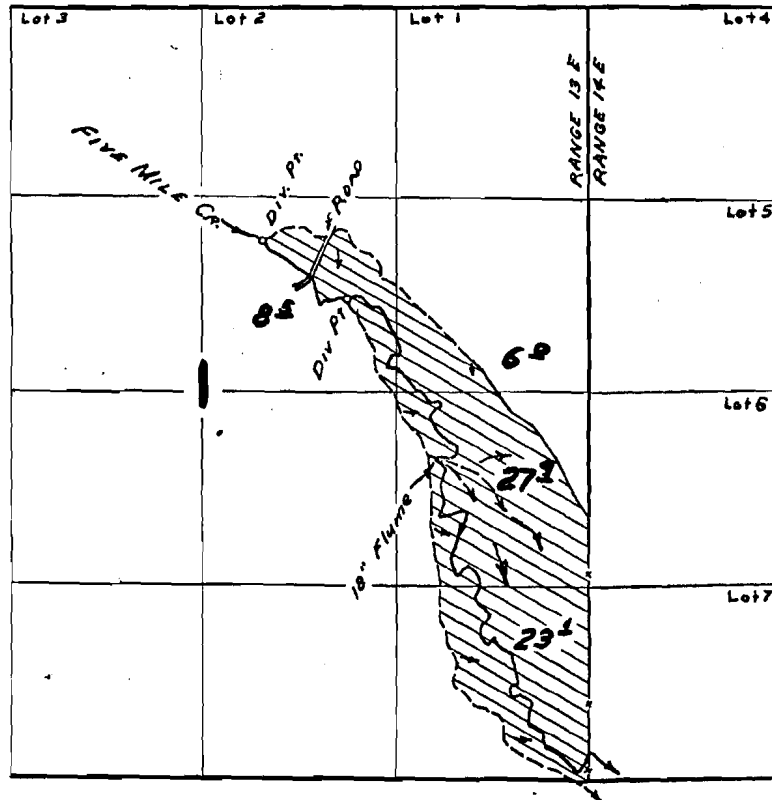

FINAL PROOF SURVEY UNDER

Application No. 33594 Permit No. 26865
IN NAME OF

HARRY OBENCHAIN

Surveyed Aug. 17, 1964, by R. JACKSON