


23367
33421

T. 34 S. R. 7 E. W.M.

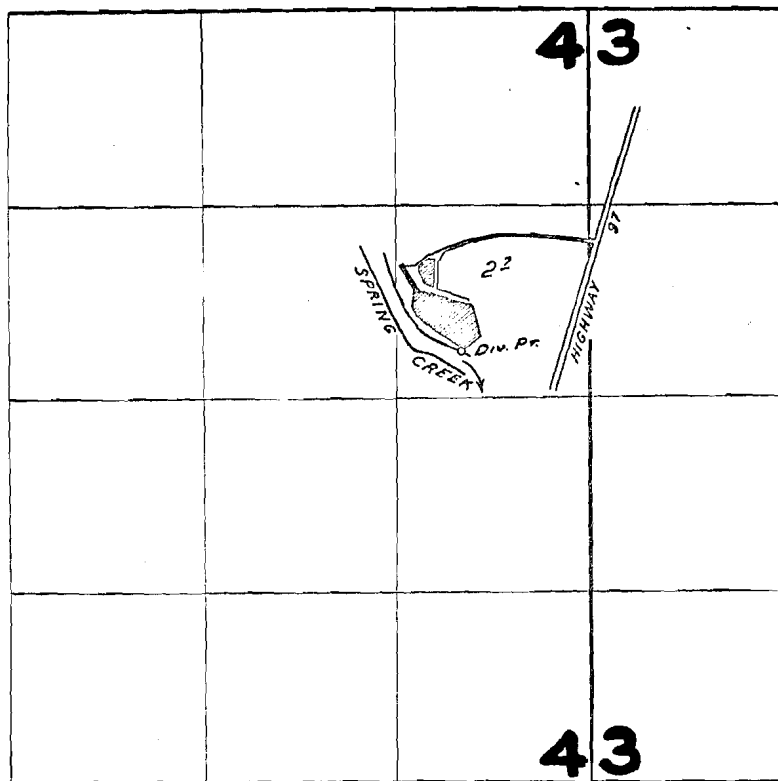

Spring Ck. & mac.

FINAL PROOF SURVEY UNDER

Application No. 29673 Permit No. 23367
IN NAME OF

MARION C. RIBBLE

Surveyed May 20, 1964, by R. JACKSON