



T. 31 & 32 S. R. 8 E. W.M.

TOWNSHIP 31 SOUTH
TOWNSHIP 32 SOUTH

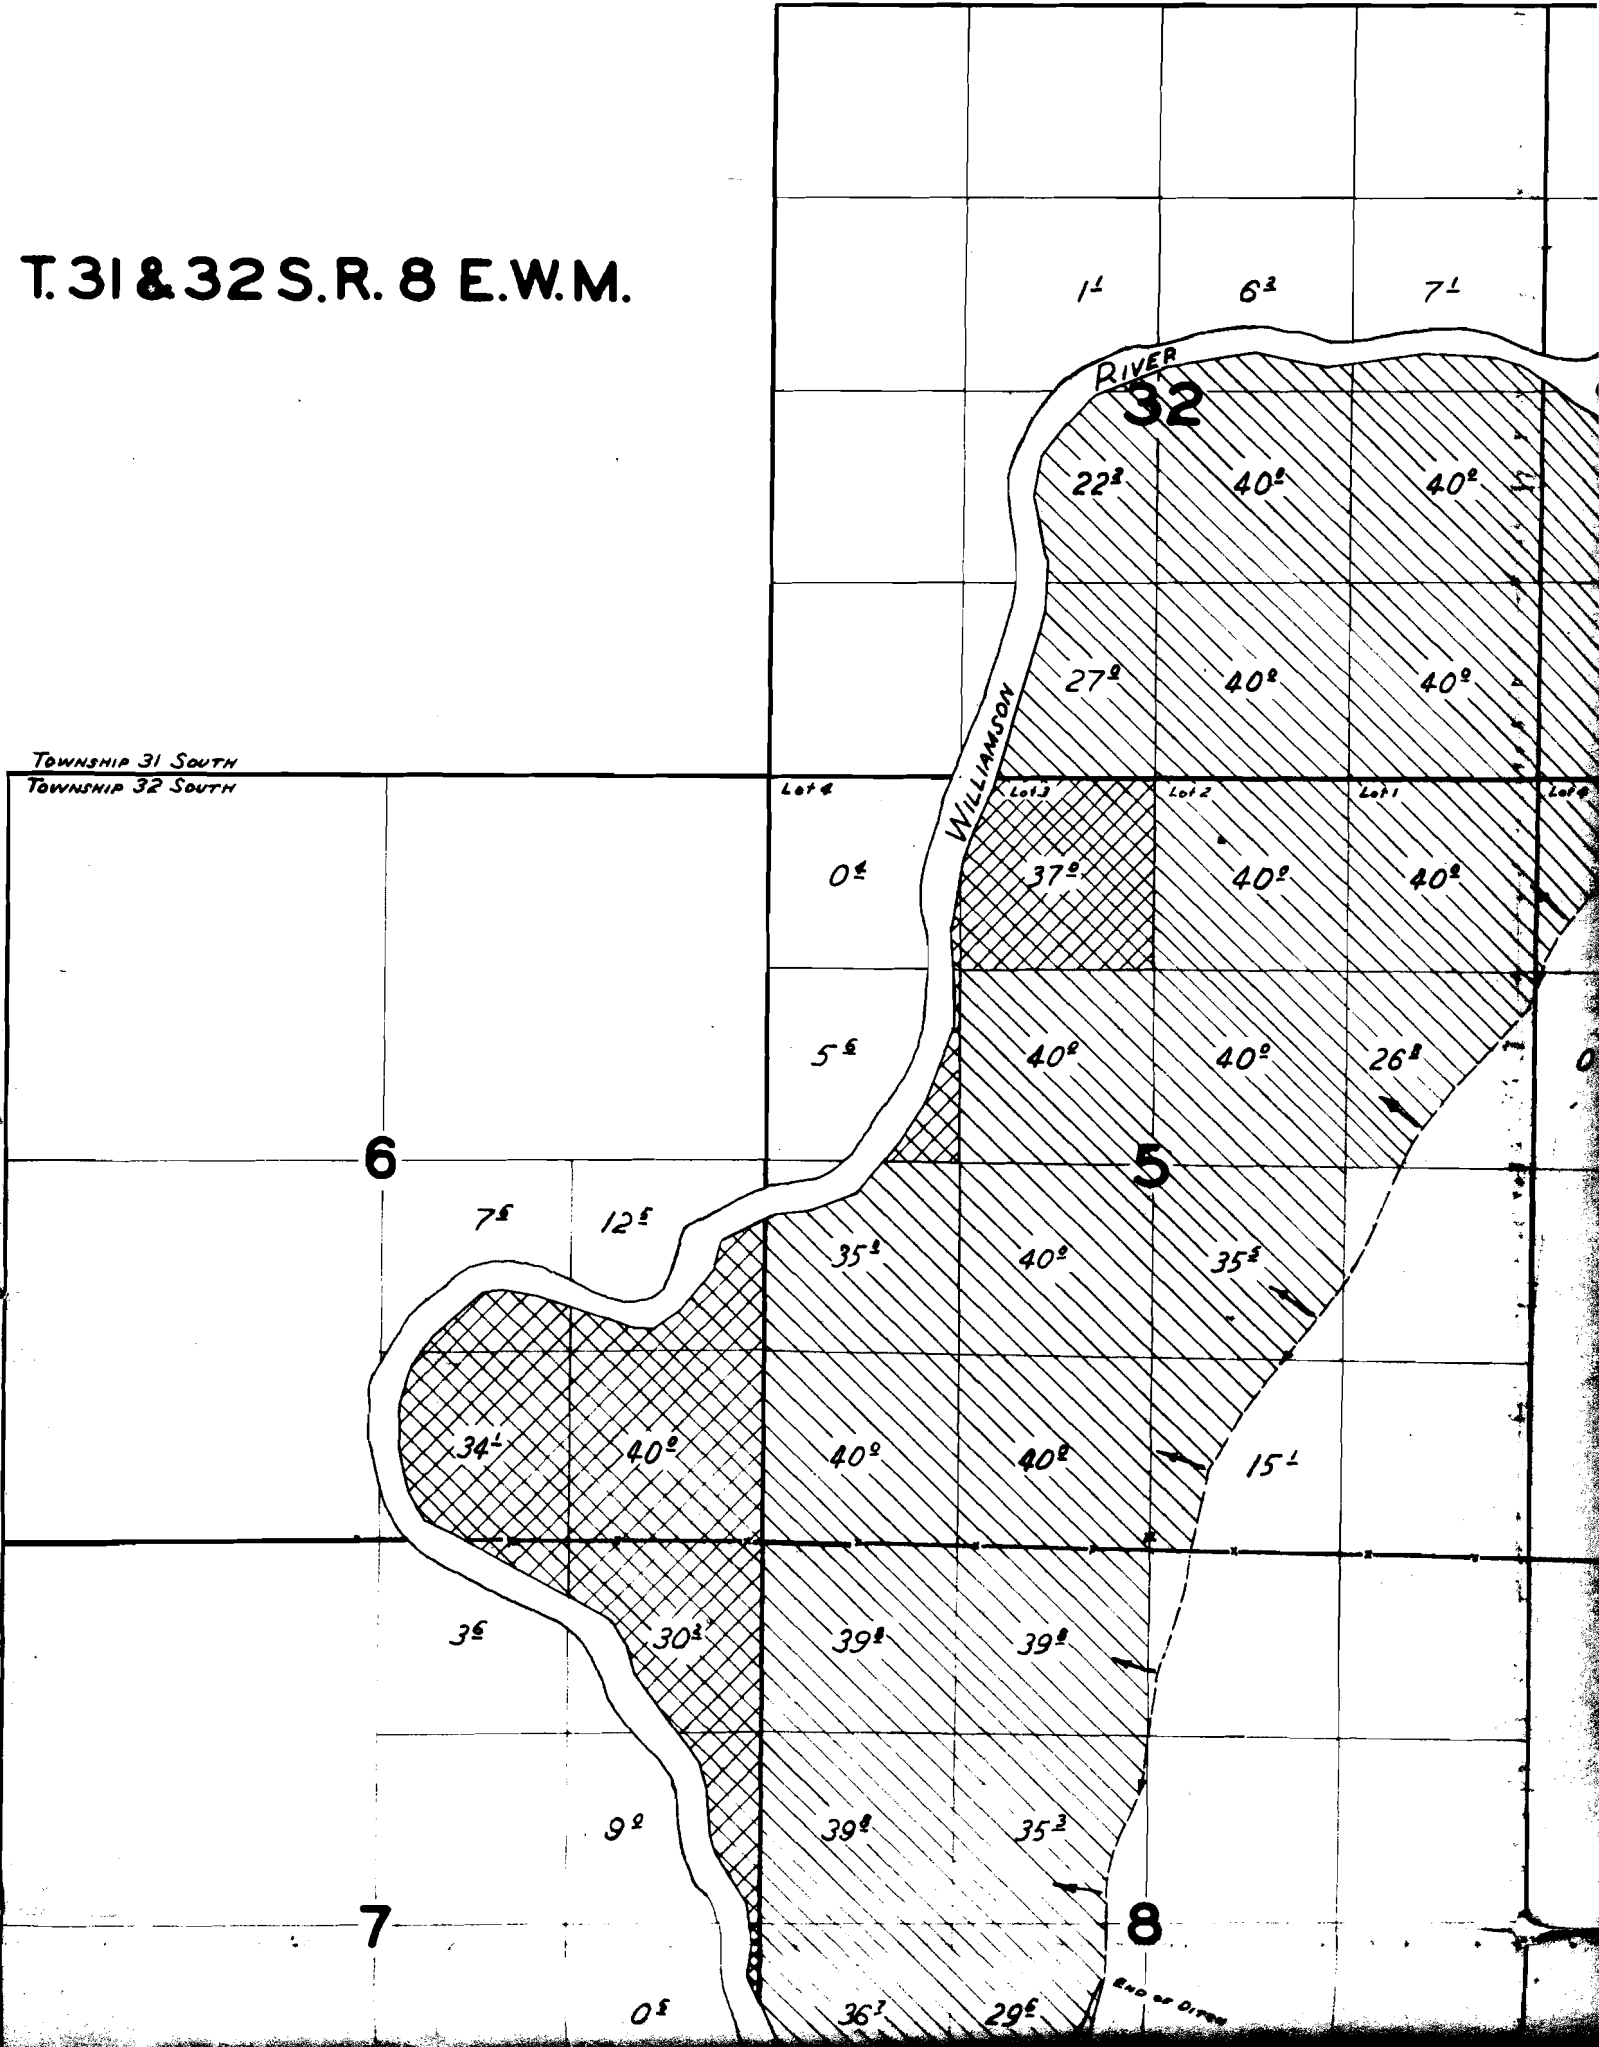

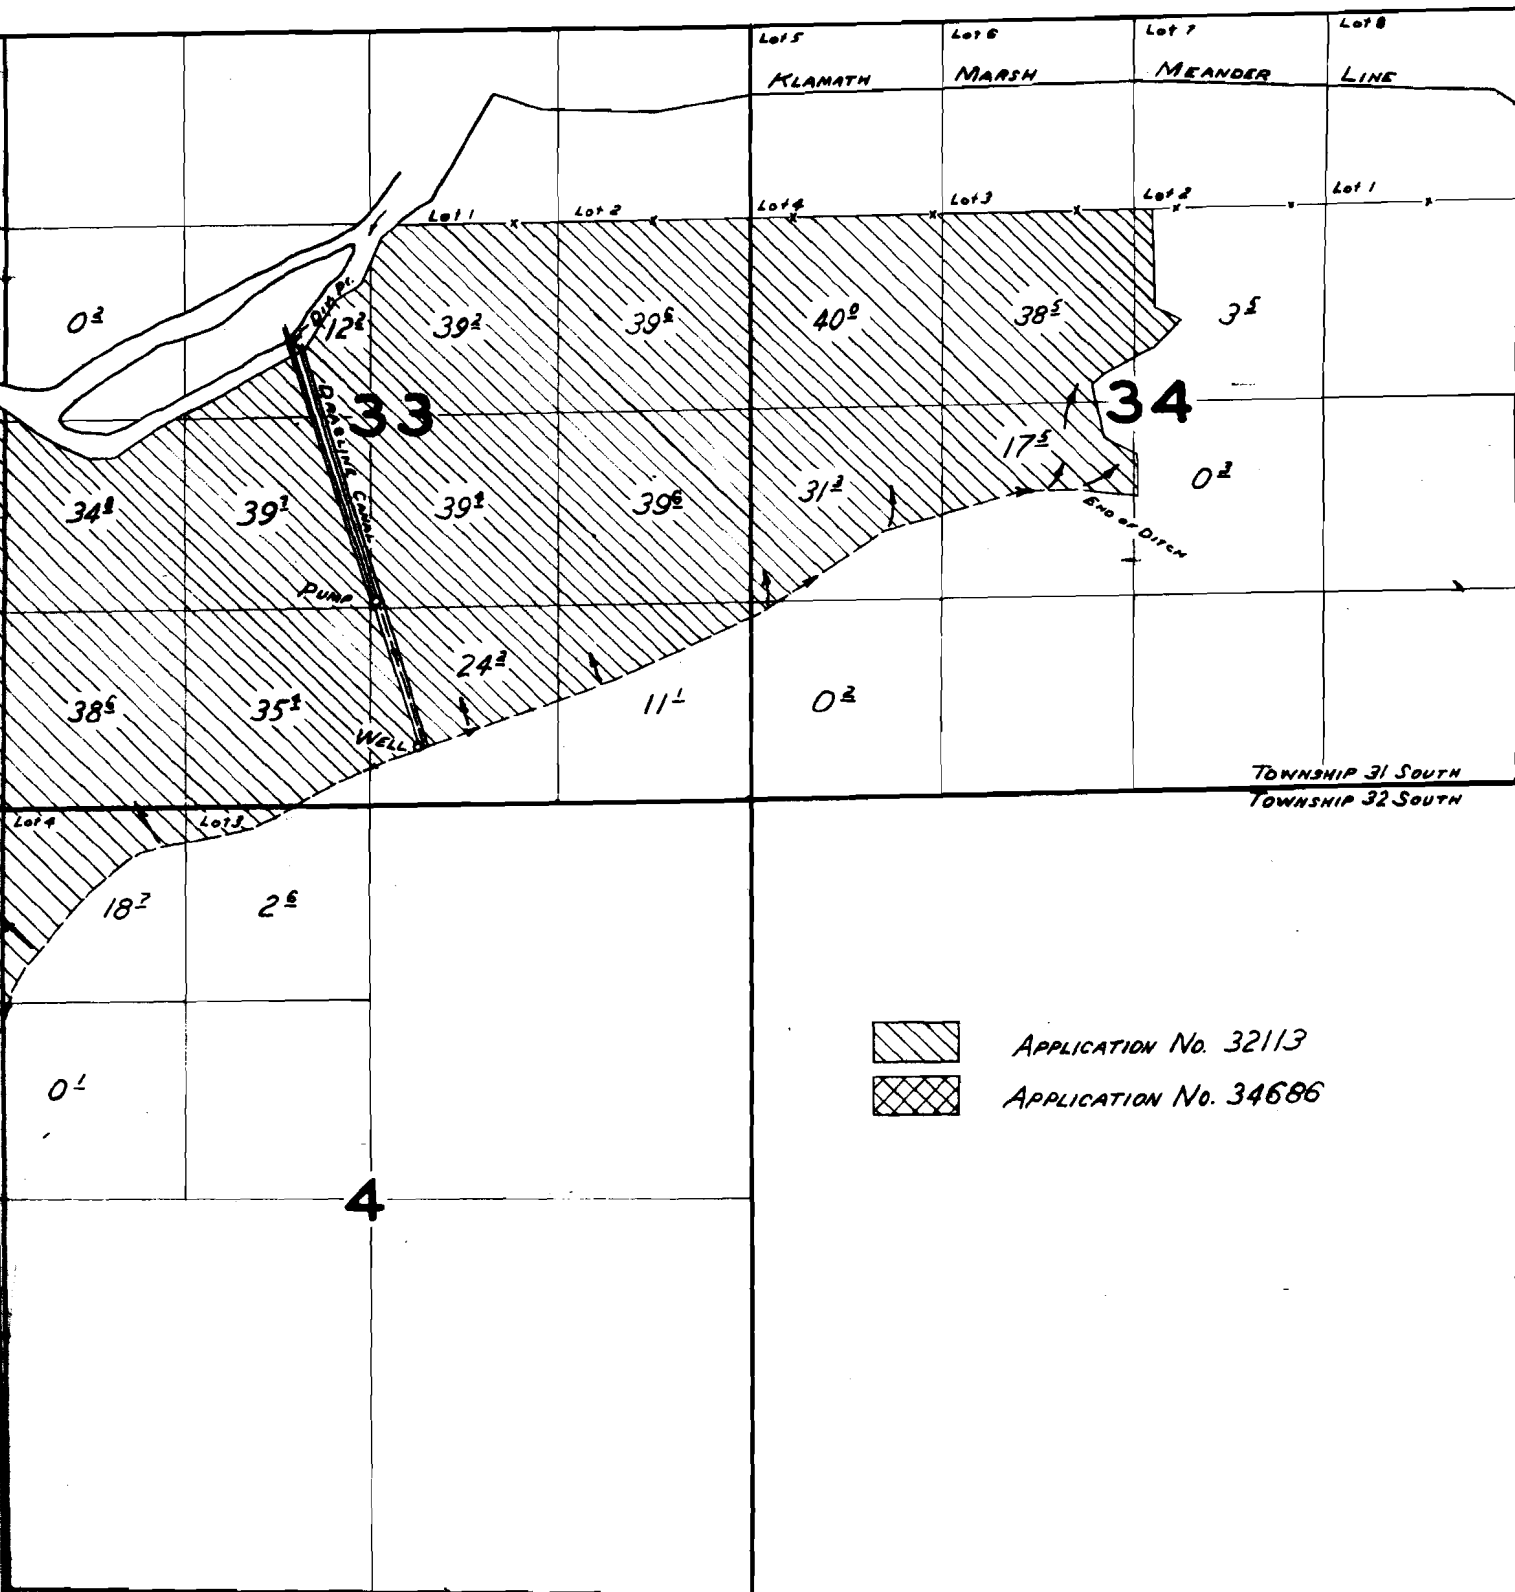

FINAL PROOF SURVEY
 UNDER

APPLICATION NO. 32113
 34686
 6-2470

PERMIT NO. 25337
 27254
 6-2303

IN NAME OF

YAMSAY LAND AND CATTLE COMPANY

SURVEYED MAY 27, 1964 BY R. JACKSON