


T.17S.R.5W.W.M.

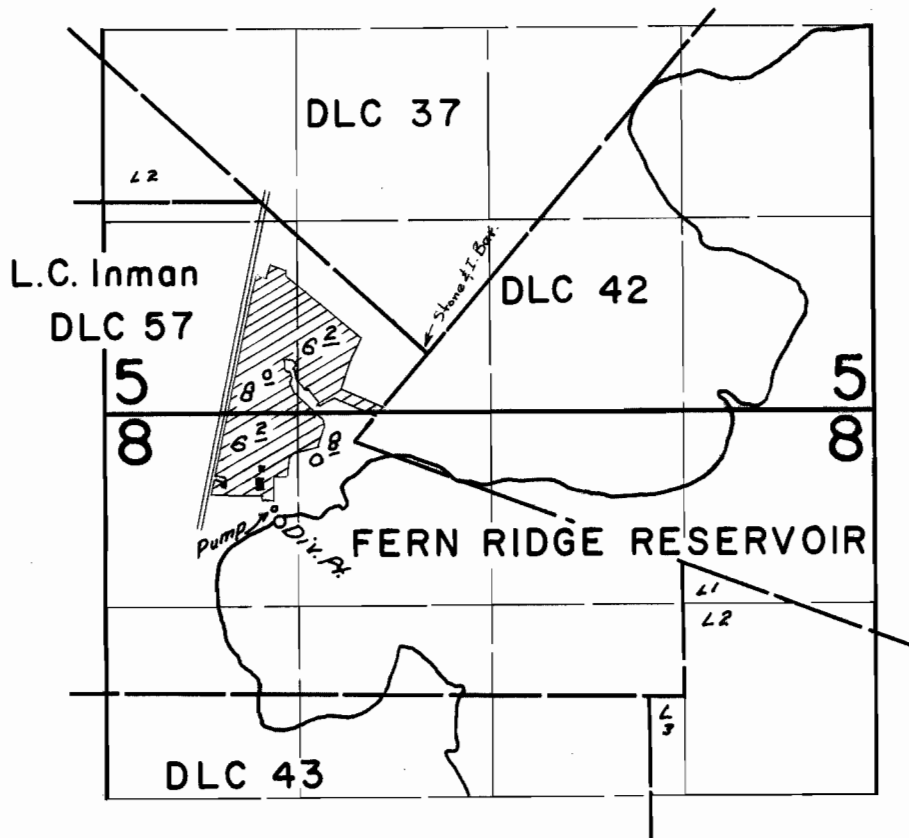

FINAL PROOF SURVEY
UNDER

Application No. 33970... Permit No. 26777.....

IN NAME OF

LLOYD BANGS

Surveyed July 10, 1964, by R. Jackson.....