


T.15S. R.7W. W.M.

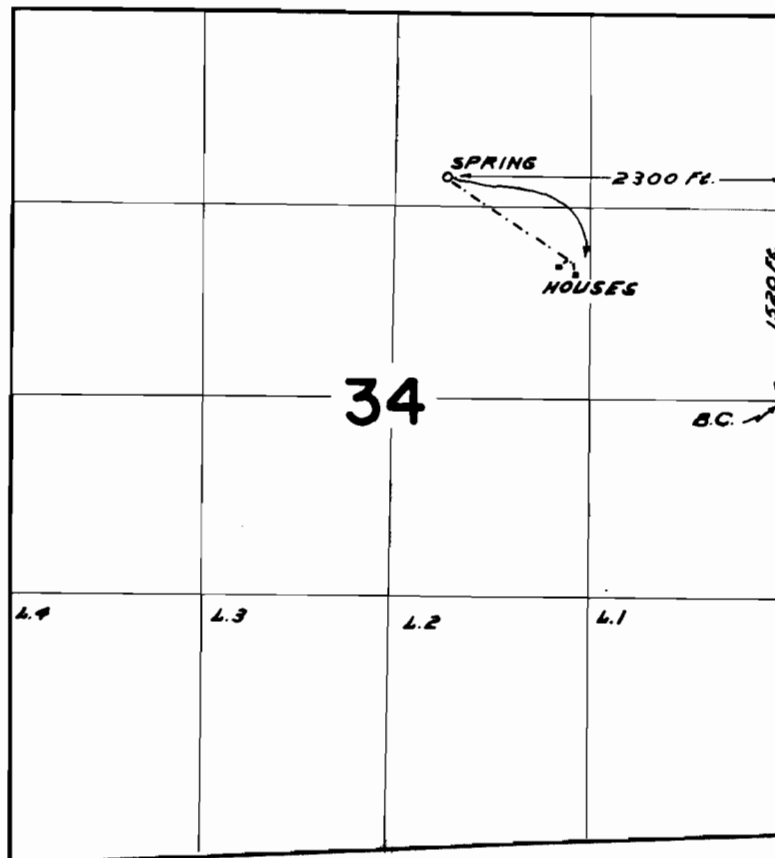

FINAL PROOF SURVEY
UNDER

Application No. 37478.. Permit No. 27901..
IN NAME OF

..... FELTON O. BARKER

Surveyed JUNE 19 1963, by C. BAKER.....