


T. 16 S. R. 4 W. W.M.

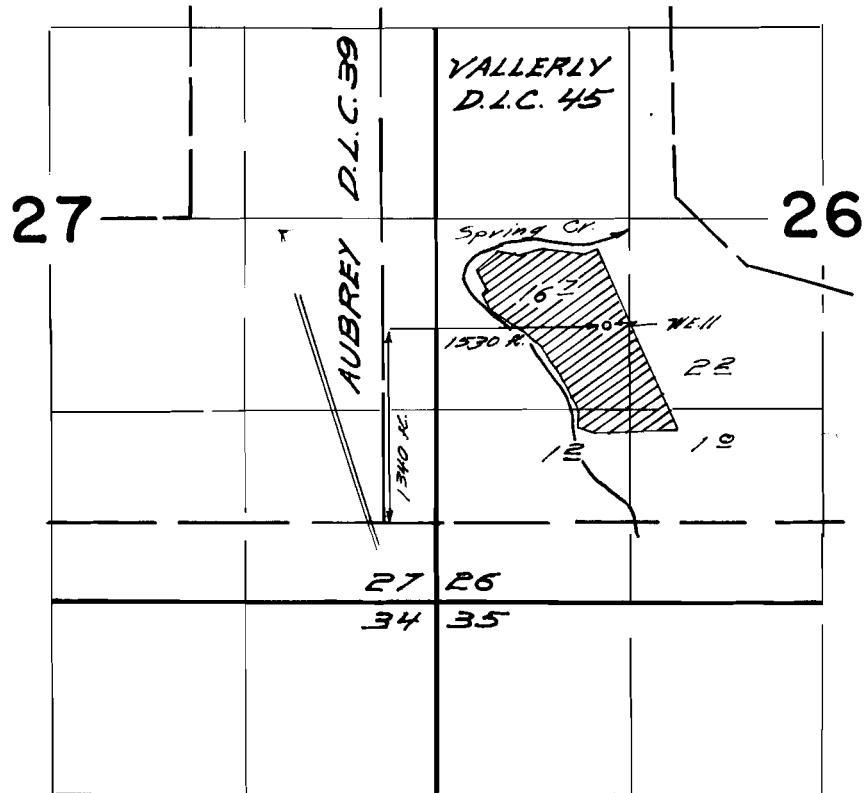

FINAL PROOF SURVEY
UNDER

Application No. *G. 2852* Permit No. *G. 2655*
IN NAME OF

Clarence & Hazel Bond

Surveyed *April 26 1965*, by *L. Colebank*.....