


T.17S.R.6W. W.M.

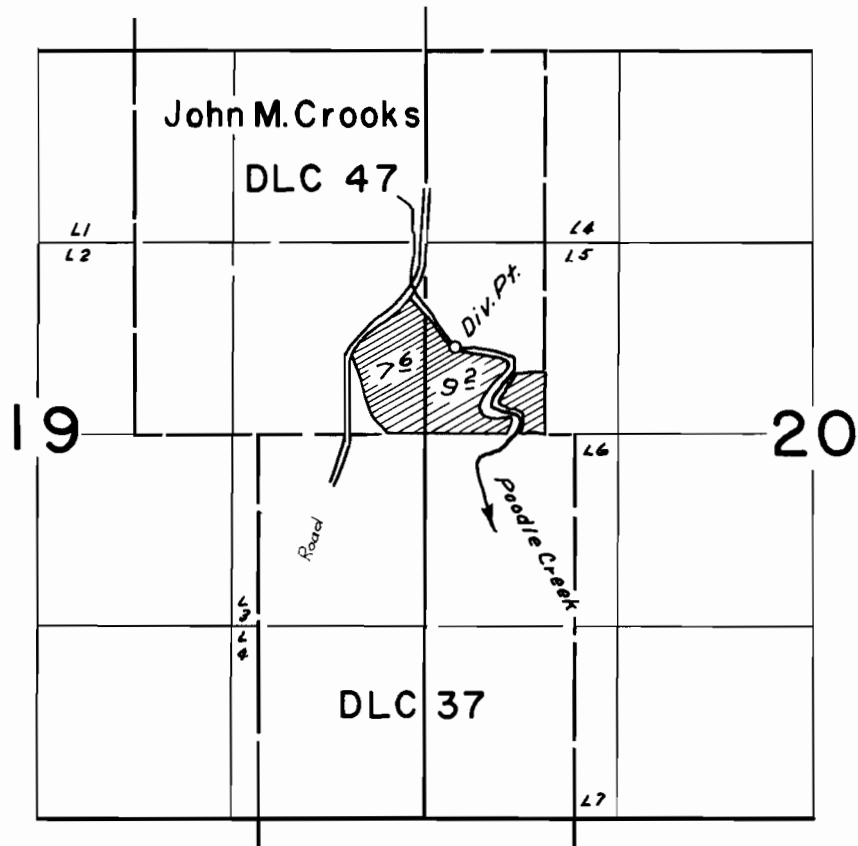

FINAL PROOF SURVEY
UNDER

Application No. 37817 Permit No. 28201
IN NAME OF

EARL C. BRUCE

Surveyed July 10, 1964, by R. Jackson