


T.19S. R.3W. W.M.

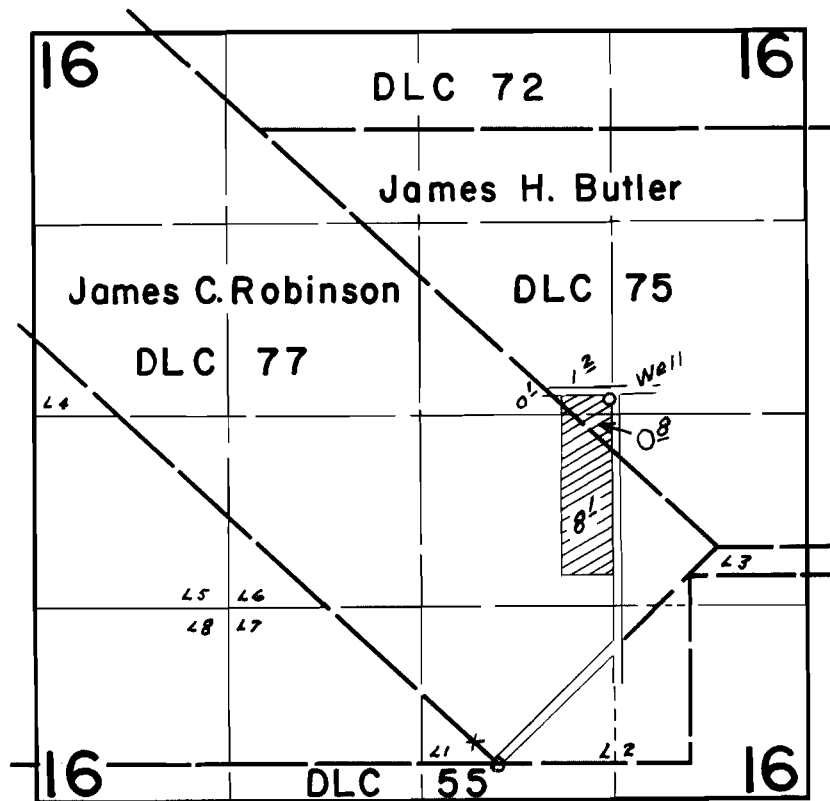

FINAL PROOF SURVEY
UNDER

Application No. G-2005 Permit No. G-1843
IN NAME OF

LEON C. & DOROTHY J. GODARD

Surveyed June 29, 1964, by R. Jackson