


T.16S. R.4 W. W.M.

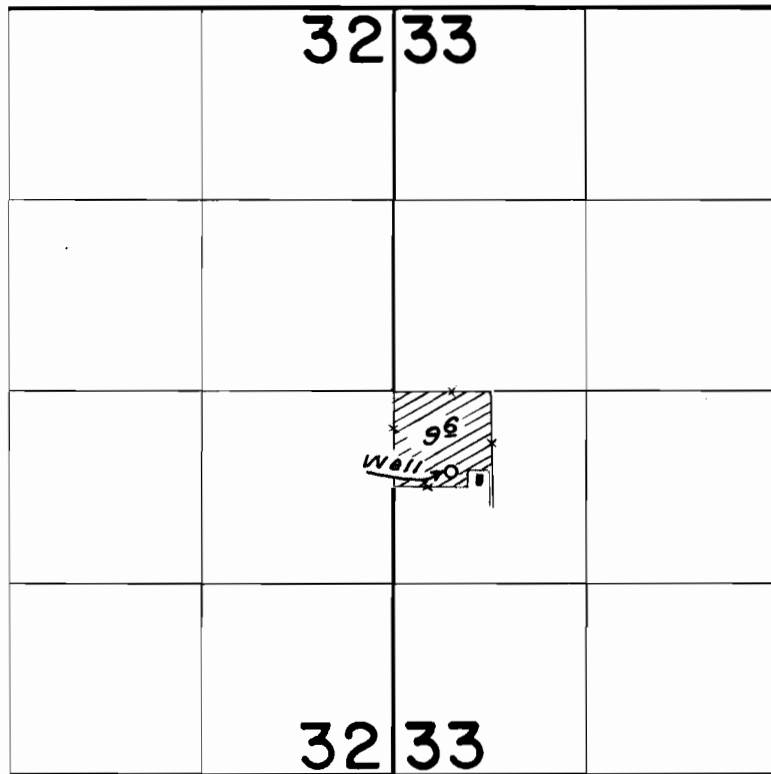

**FINAL PROOF SURVEY**  
UNDER

Application No. G-2630. Permit No. G-2484.  
IN NAME OF

LUCILLE A. FOLEY

Surveyed July 10, 1964, by R. Jackson