


T.20S.R.3 W. W.M.

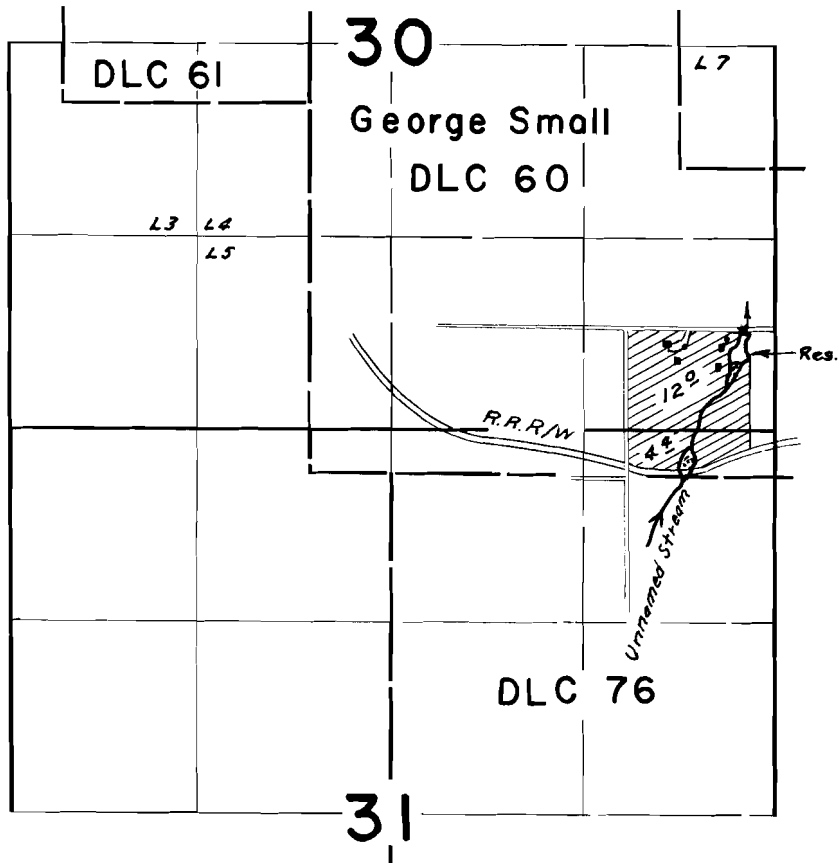

FINAL PROOF SURVEY
UNDER

35054 27479
Application No. R-36121 Permit No. R-2646
IN NAME OF

ARTHUR P. & LORENE McDONALD

Surveyed July 2, 1964, by R. Jackson