


T.20S.R.3 W. W.M.

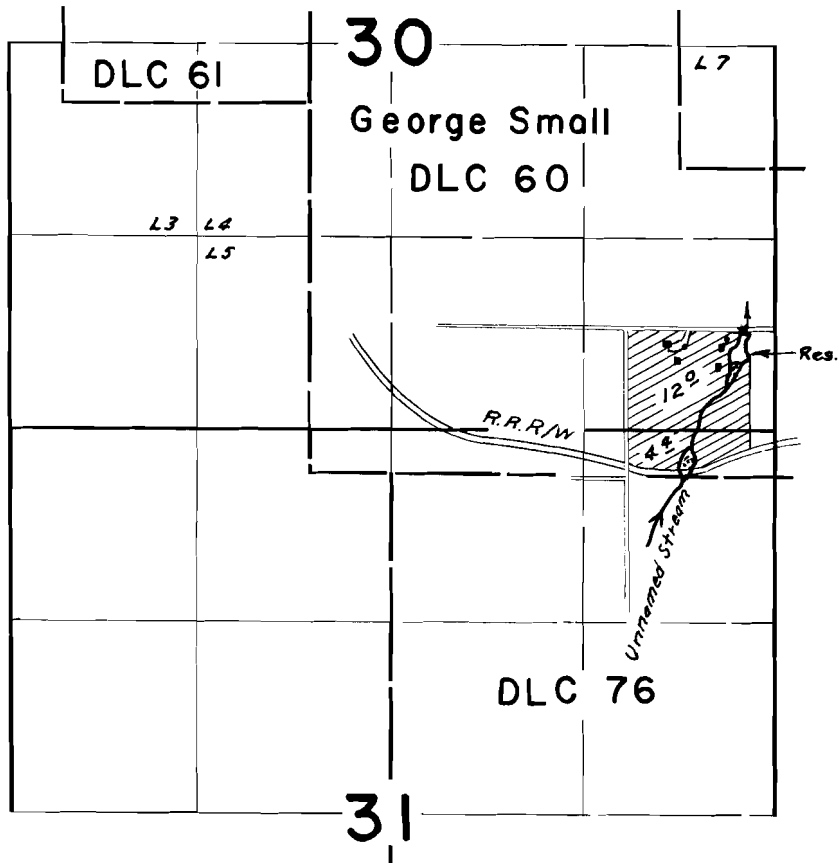

**FINAL PROOF SURVEY**  
UNDER

35054                      27479  
Application No. R-36121    Permit No. R-2646  
IN NAME OF

**ARTHUR P. & LORENE McDONALD**

Surveyed July 2, 1964, by R. Jackson