


T.21S.R.2W.W.M.

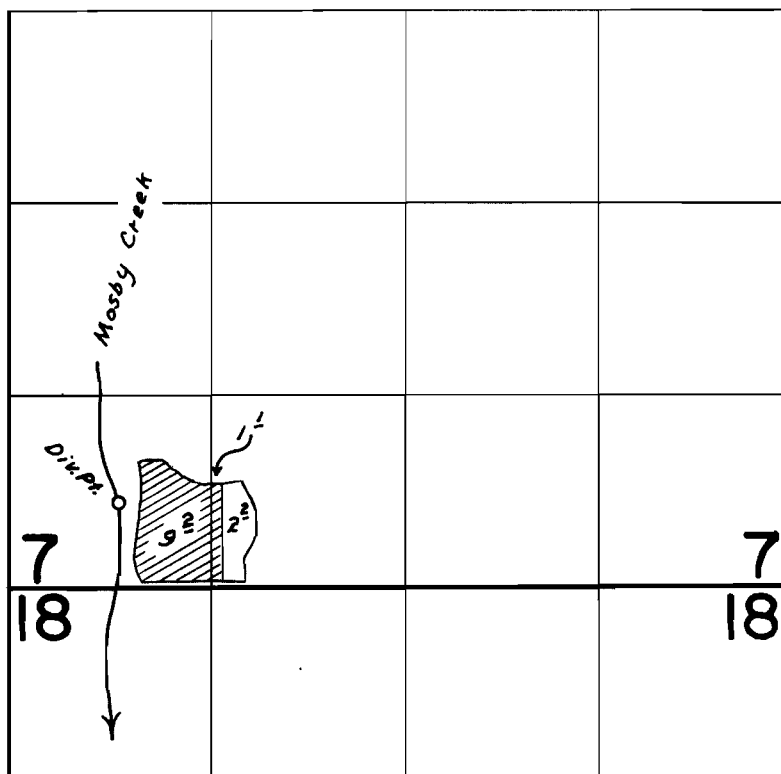

FINAL PROOF SURVEY
UNDER

Application No. 38103... Permit No. 28439
IN NAME OF

ROBERT B. MERRICK

Surveyed June 30, 1964, by R. Jackson.....