


33434

T.31S.R.16E.W.M.

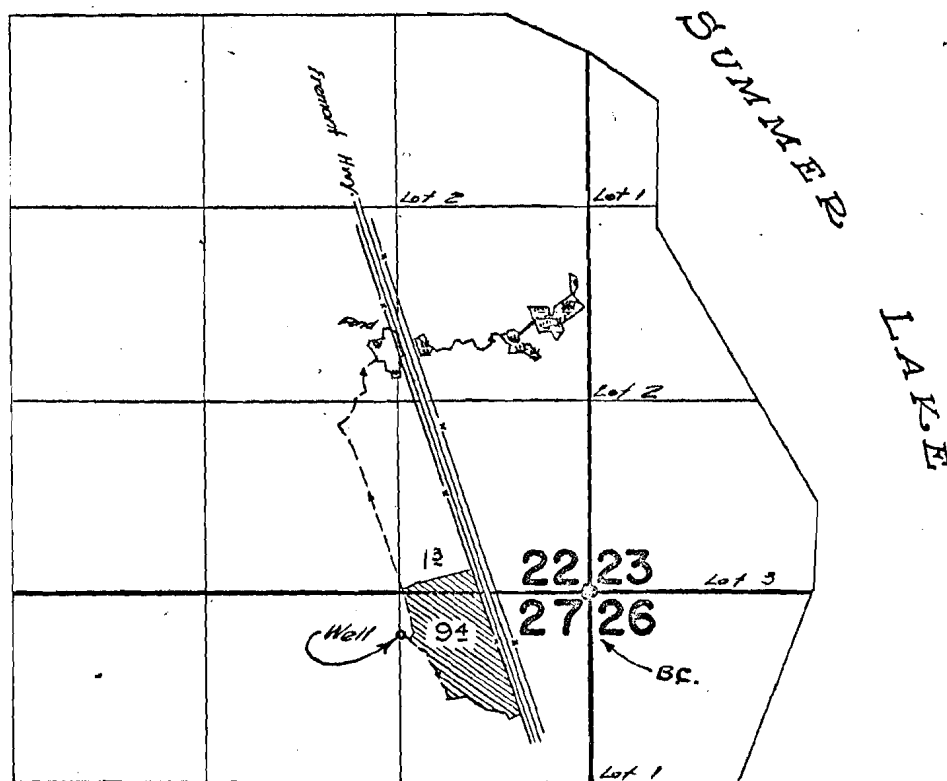

FINAL PROOF SURVEY UNDER

Application No. G-1974 Permit No. G-1810
IN NAME OF

DAVID T. O'CONNOR

Surveyed Sept. 14, 1964, by

H. J. Johnson

✓