


T.19S. R.3 W. W.M.

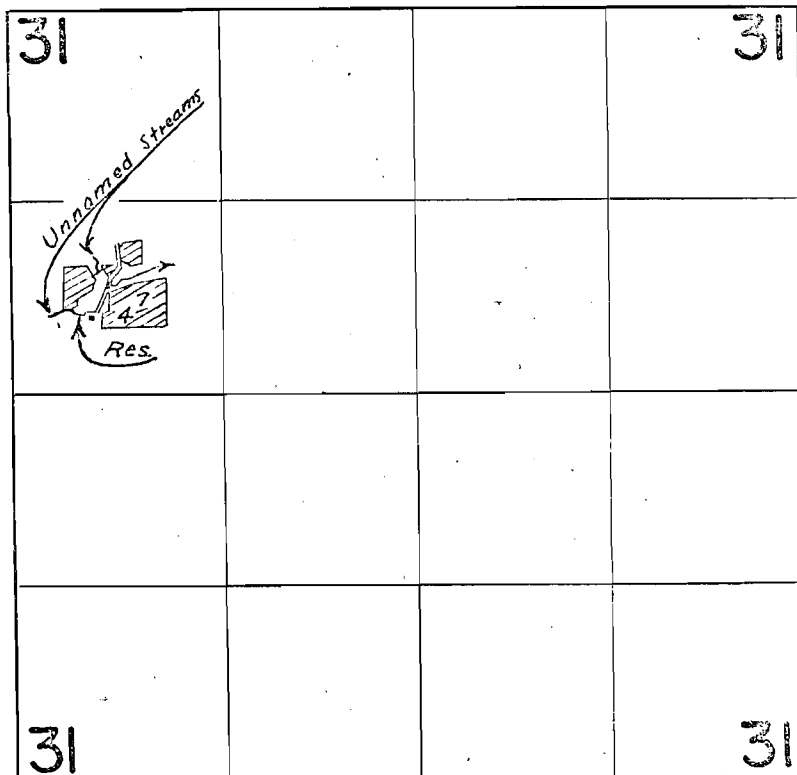

FINAL PROOF SURVEY
UNDER

34509 27105
Application No. R-34508 Permit No. R-2574...
IN NAME OF

JAMES DUGANE PEMBROOK

Surveyed July 2, 1964, by R. Jackson.....