


T.19S. R.3 W. W.M.

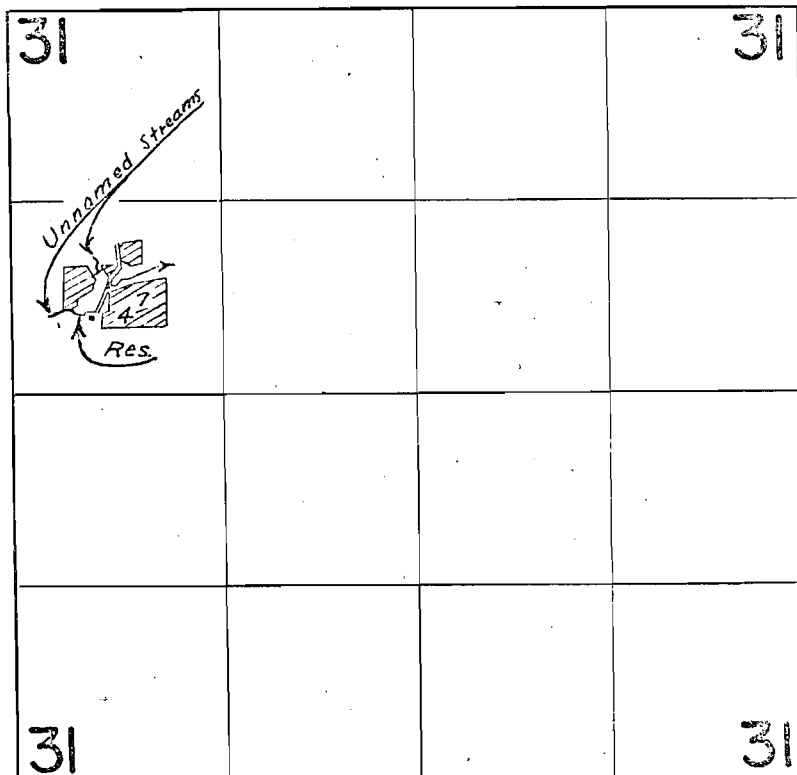

FINAL PROOF SURVEY
UNDER

Application No. 34509 Permit No. 27105
R-34508 R-2574
IN NAME OF

JAMES DUGANE PEMBROOK

Surveyed July 2, 1964, by R. Jackson