


T.17S. R.2W. W.M.

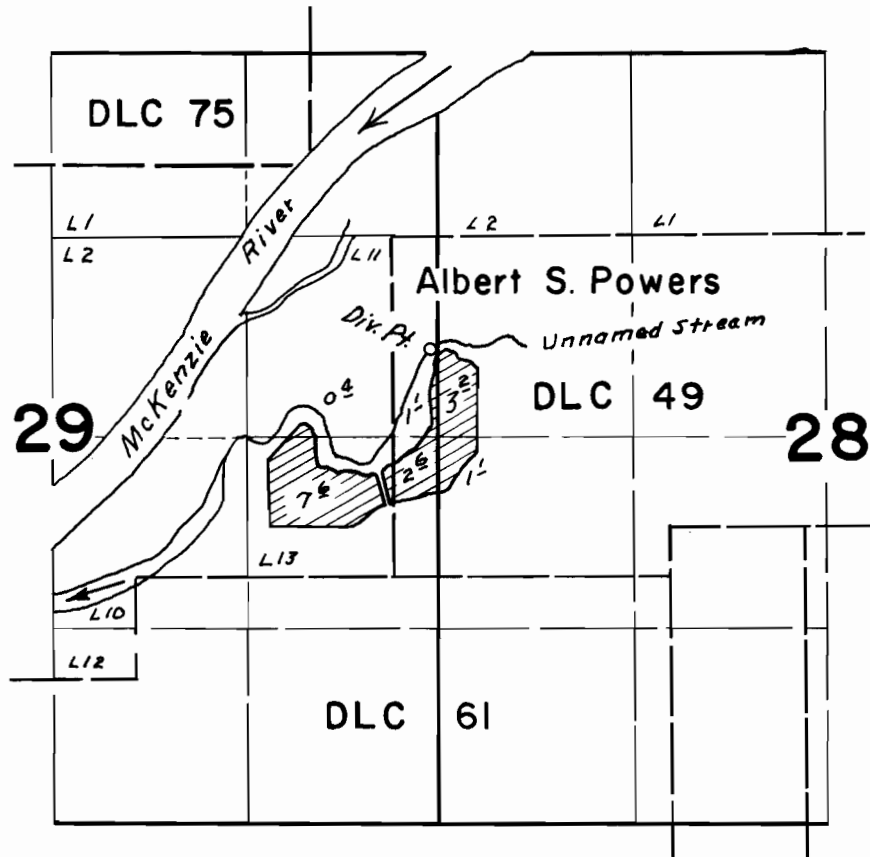

FINAL PROOF SURVEY UNDER

Application No. 34883 ... Permit No. 27525 ...
IN NAME OF

ARTHUR R. & HELEN QUACKENBUSH

Surveyed May 7, 1964, by R. Jackson