


T.15S. R.4W. W.M.

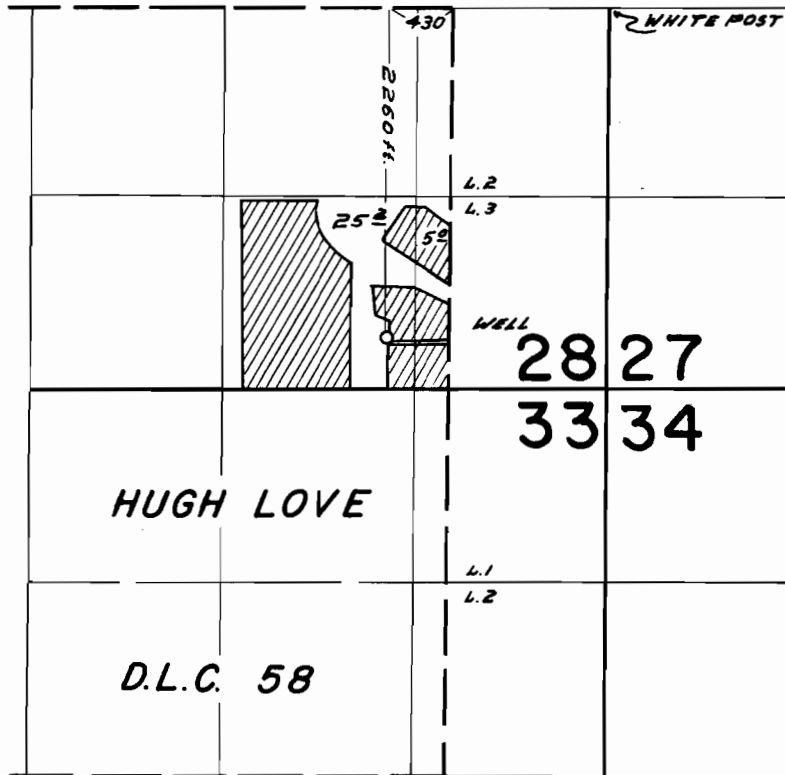

FINAL PROOF SURVEY
UNDER

Application No. 6-2733 Permit No. 6-2534
IN NAME OF

CRIS & THORA RASMUSSEN

Surveyed APR 28 1965, by L. COLEBANK