


T.16S. R. 4 W. W.M.

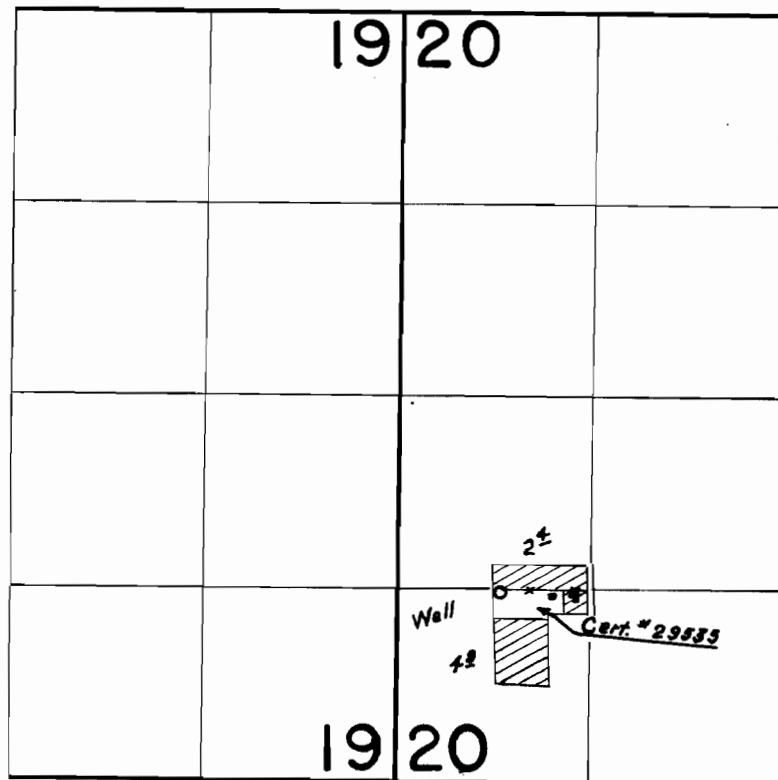

FINAL PROOF SURVEY
UNDER

Application No. G-2236 Permit No. G-2059
IN NAME OF

J. FRANCIS SANDERS

Surveyed July 10, 1964, by R. Jackson