


T.17S. R.4W. W.M.

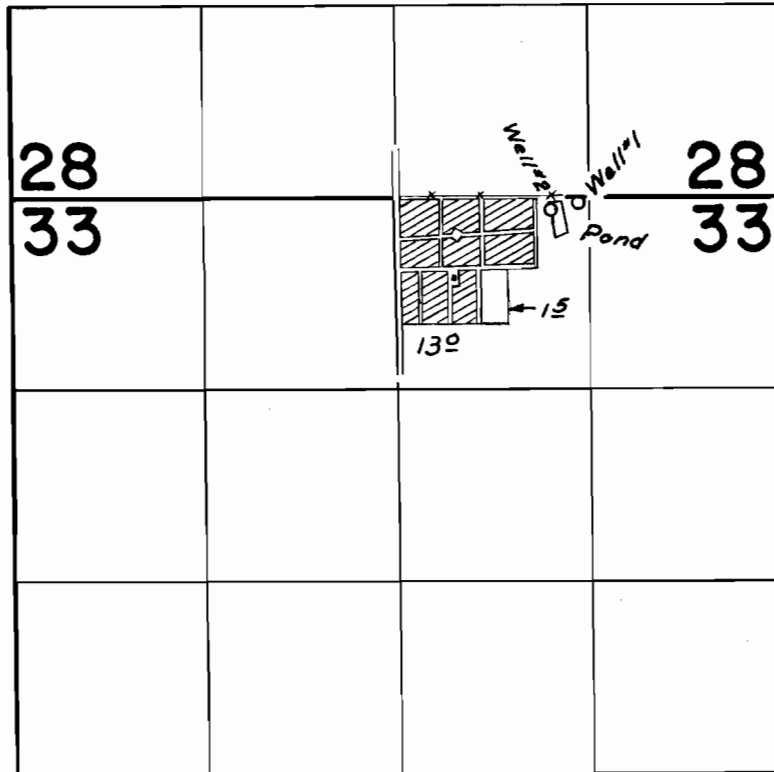

**FINAL PROOF SURVEY**  
UNDER

G-2712                      G-2519  
Application No. G-2700. Permit No. G-2504.  
IN NAME OF

**WEST LAWN MEMORIAL PARK**

Surveyed May 4, 1964, by B. Jackson.....