


T.17S. R.4W. W.M.

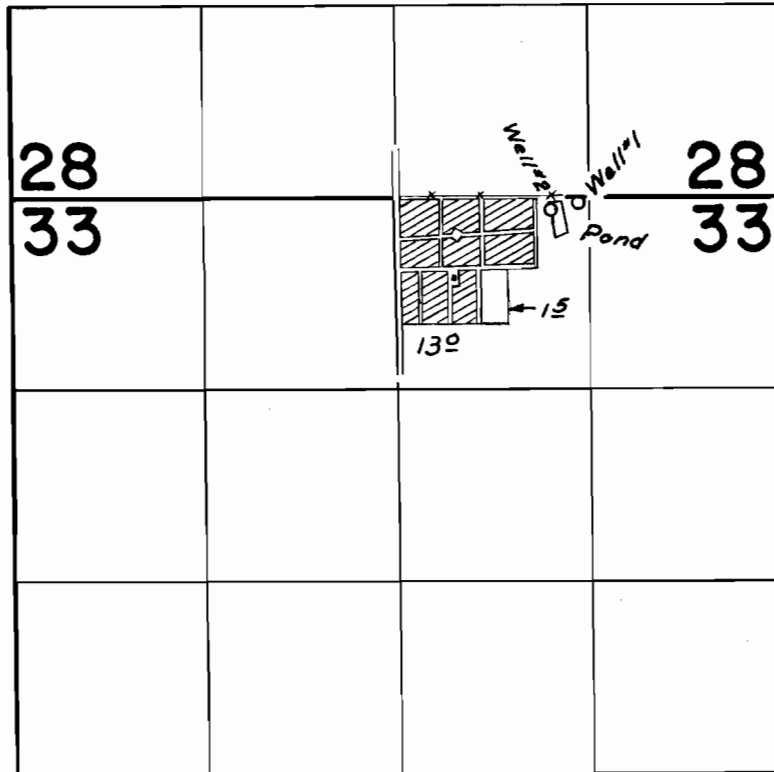

FINAL PROOF SURVEY
UNDER

G-2712 G-2519
Application No. G-2700. Permit No. G-2504.
IN NAME OF

WEST LAWN MEMORIAL PARK

Surveyed May 4, 1964, by B. Jackson.....