


T.20S.R.3W. W.M.

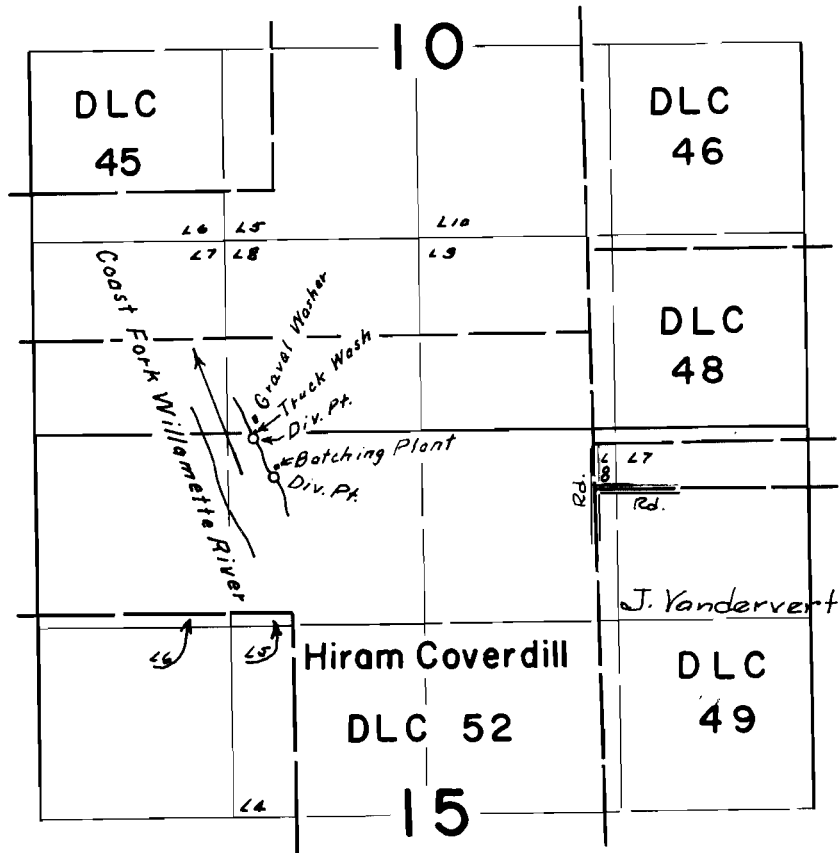

FINAL PROOF SURVEY UNDER

Application No. 38237 Permit No. 28562
 IN NAME OF
 Zumwalt and Williams Sand and Gravel Co.
 Cottage Grove Ready-Mix

Surveyed July 2, 1964, by R. Jackson...