


T.11S.R.2W.W.M.

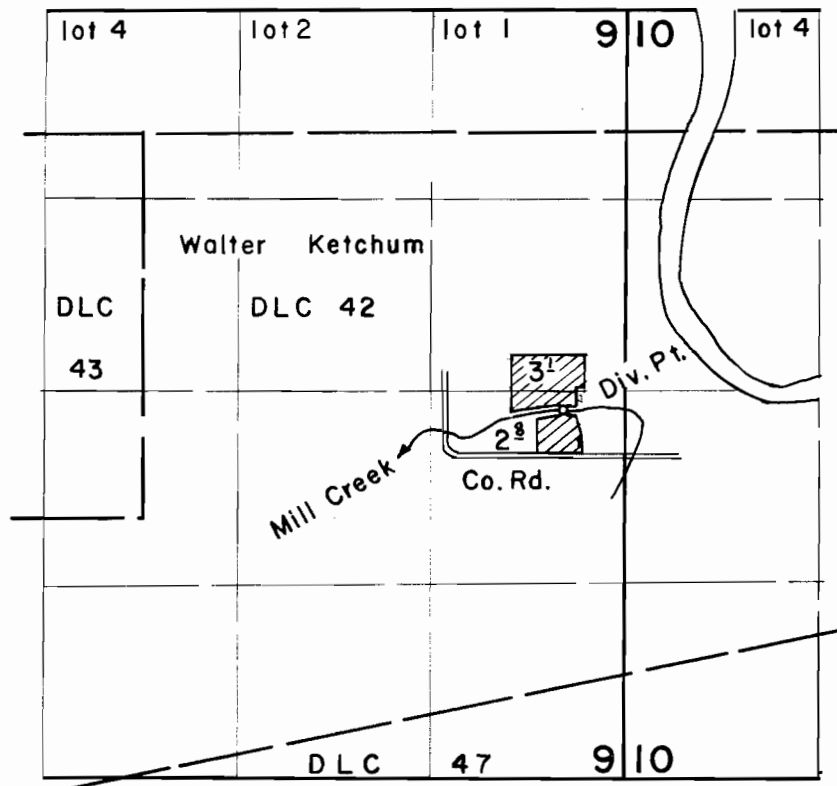

FINAL PROOF SURVEY
UNDER

Application No. 39333 Permit No. 29286
IN NAME OF

Robert O. & Gloria J. Bash

Surveyed Nov. 5, 1964, by R. Jackson