


T.10 S.R. 2 W.W.M.

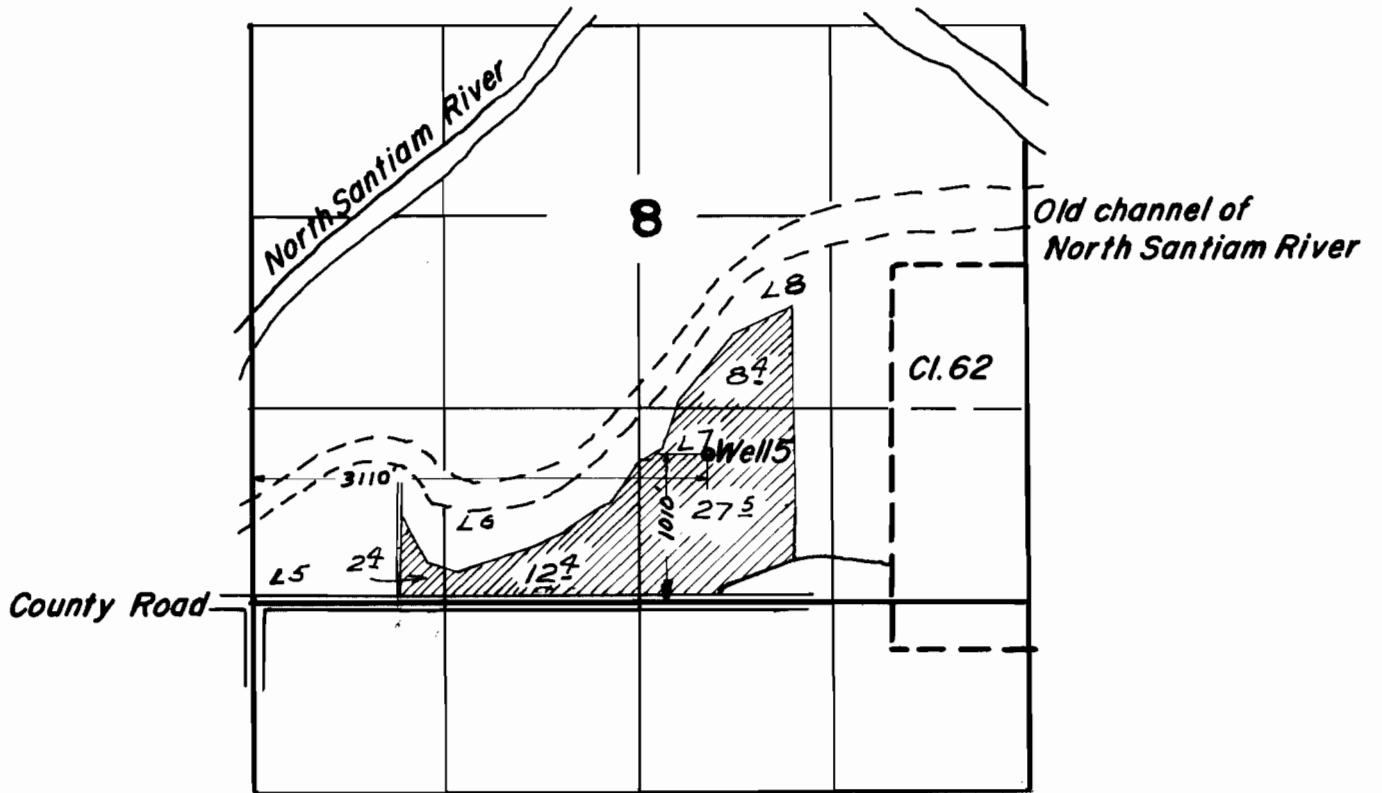

FINAL PROOF SURVEY
UNDER

Application No. G-2.289 Permit No. G-2113
IN NAME OF

William Uppstad

Surveyed Dec. 11, 1962, by F. Siegmund
Jan. 13, 1966