T.14S.R. 40E.W.M.

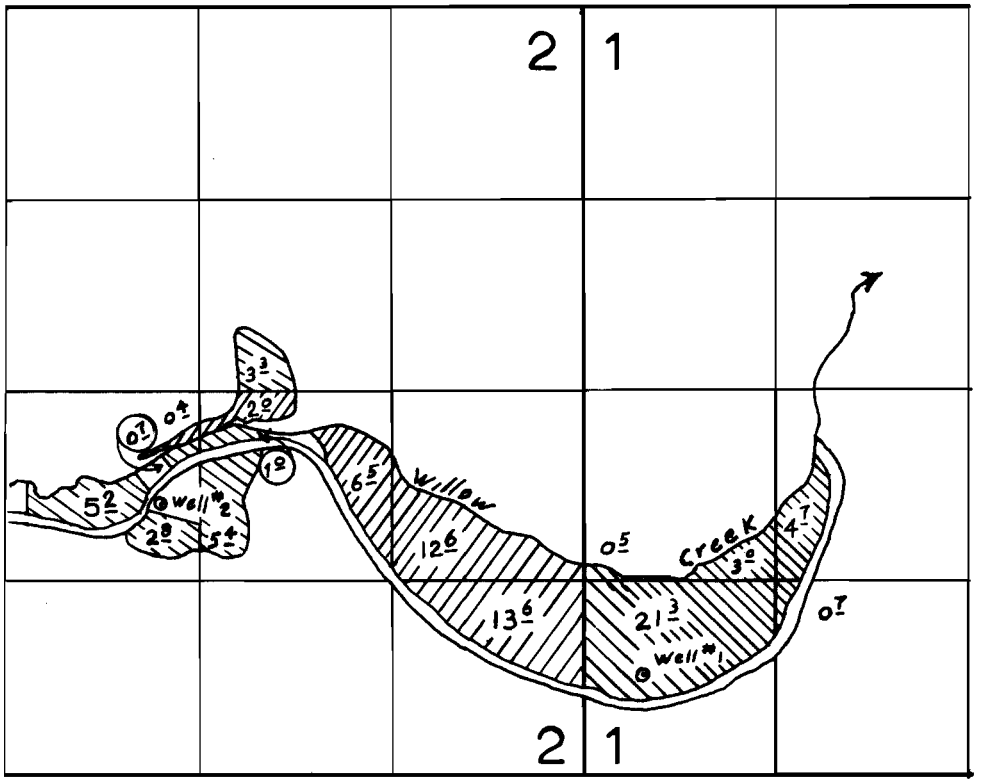

FINAL PROOF SURVEY
UNDER

G-2220 G-2134
Application No. G-2221 Permit No. G-2135
IN NAME OF

OTTO BRONSON

Surveyed APRIL 16 1965, by F.W. Elfving

BBC-17N-165