


T.14S.R. 40E.W.M.

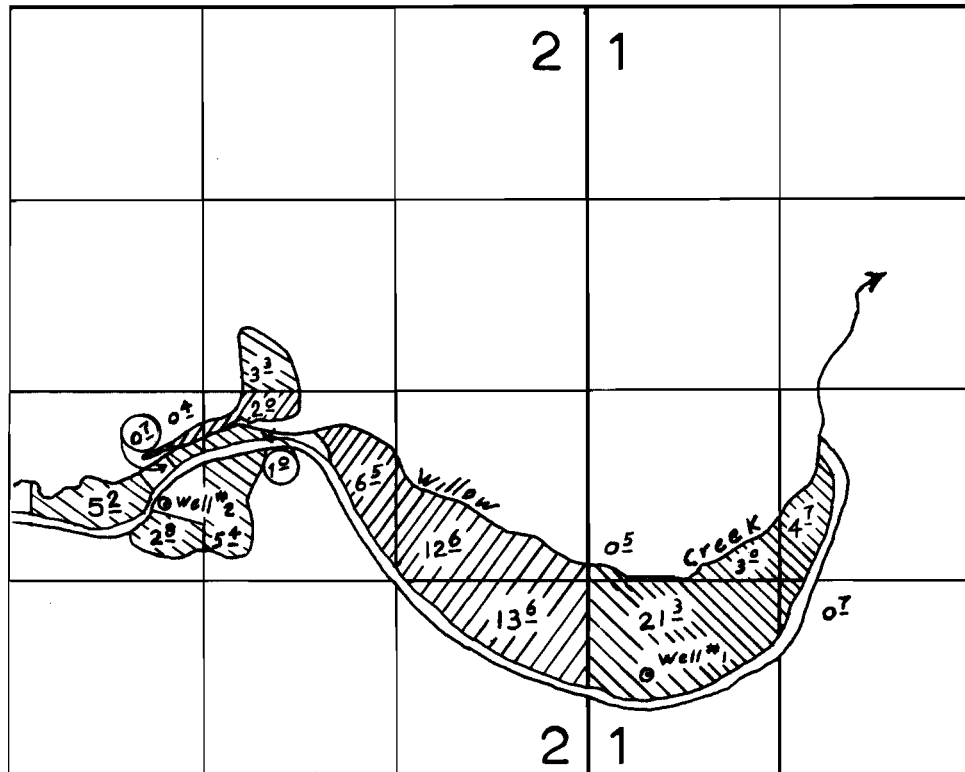

FINAL PROOF SURVEY

UNDER

Application No. G-2220 Permit No. G-2134
G-2221 G-2135
 IN NAME OF _____

OTTO BRONSON

Surveyed APRIL 16, 1965, by F.W. Ellinger