


T.17 & 18S. R.39E.W.M.

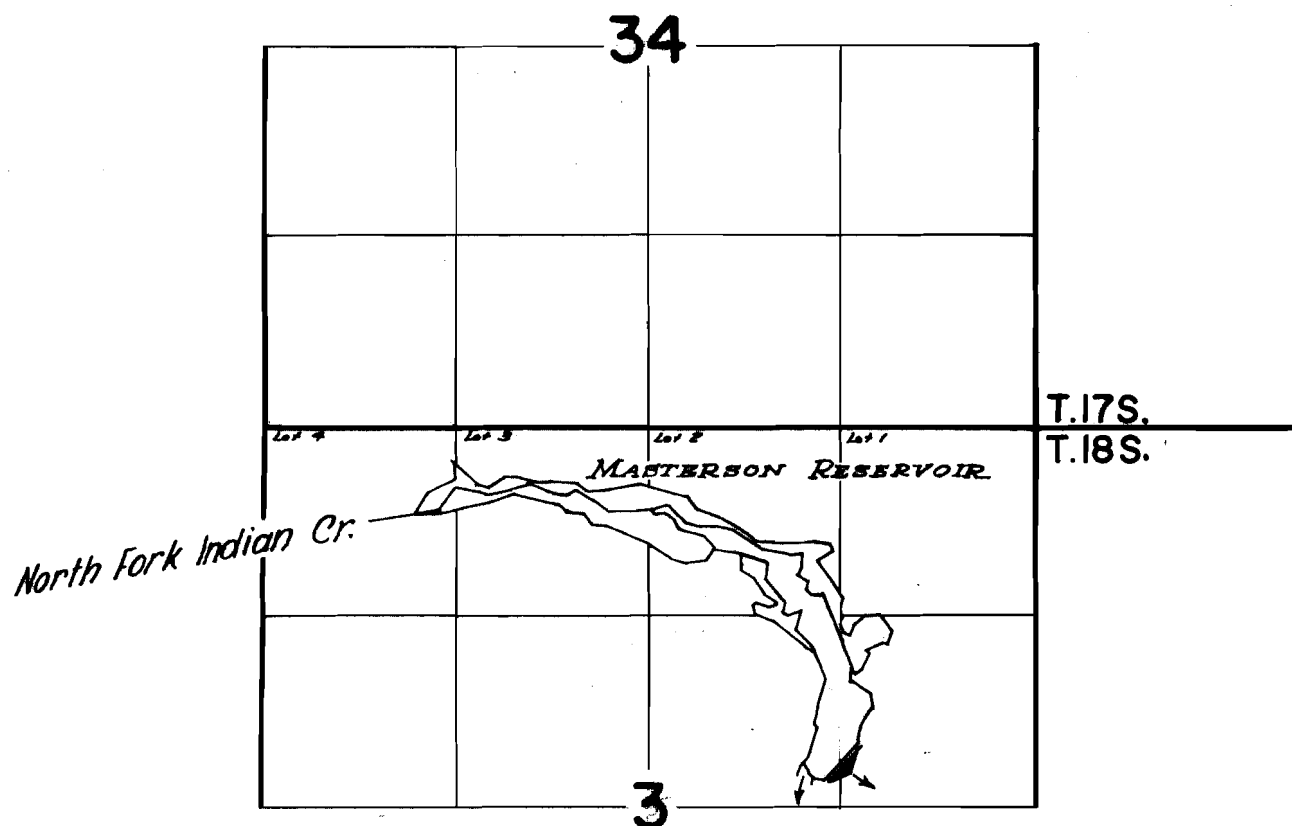

FINAL PROOF SURVEY
UNDER

Application No. R-24361 Permit No. R-1004
IN NAME OF

F. C. VAUGHAN

Surveyed Oct. 16 1965, by L. Coalbank