


T.18S.R.40E.W.M.

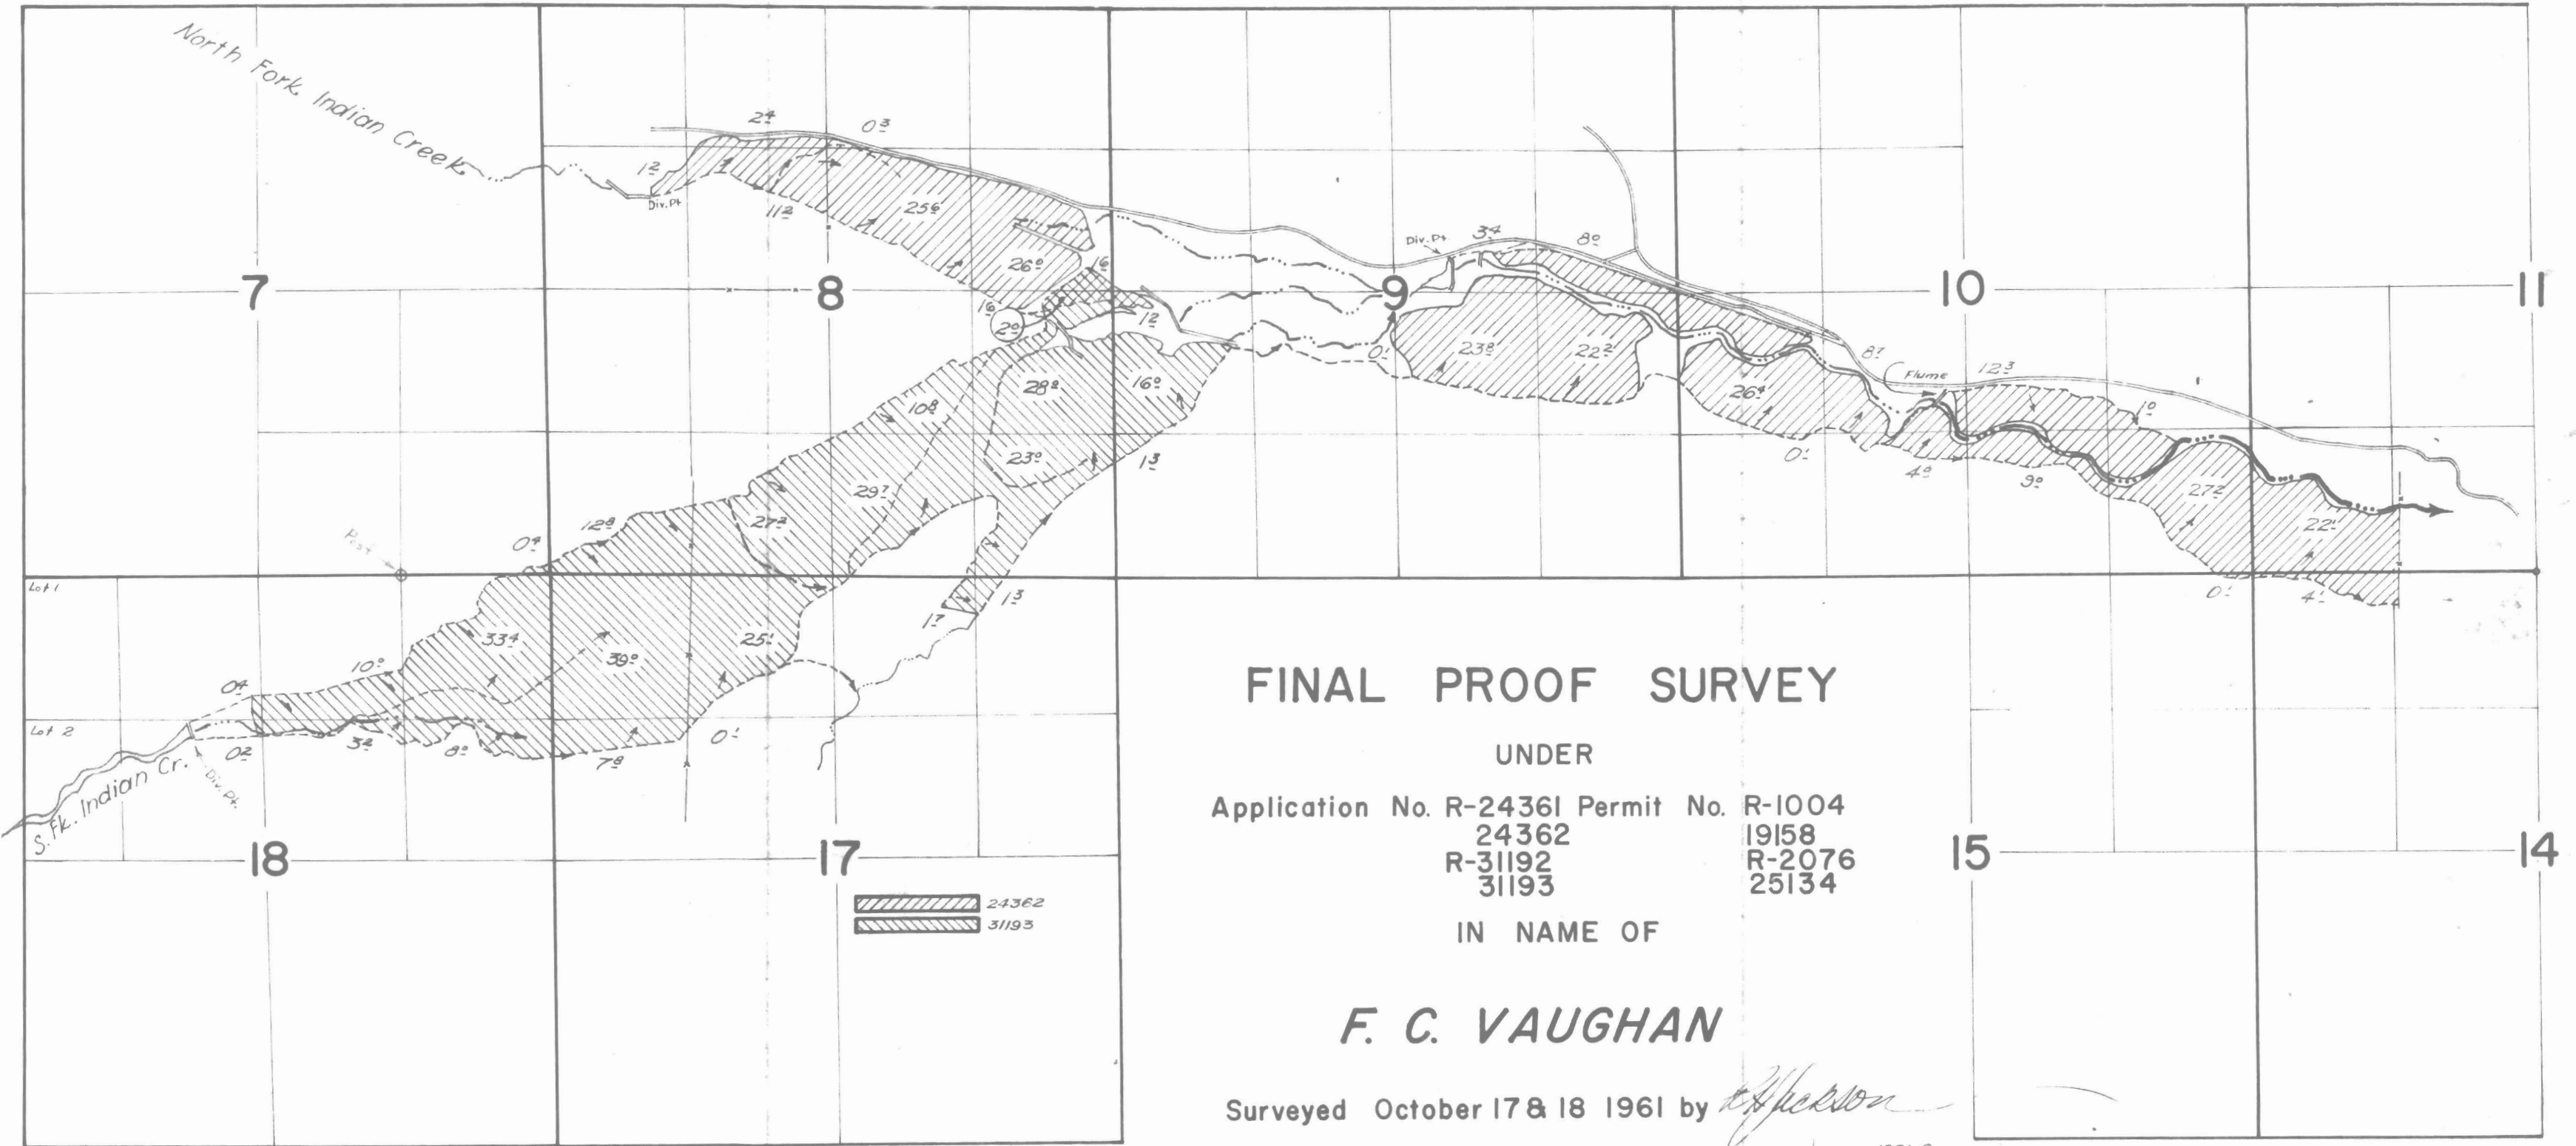

# FINAL PROOF SURVEY

UNDER

Application No. R-24361 Permit No. R-1004  
 24362 19158  
 R-31192 R-2076  
 31193 25134

IN NAME OF

## F. C. VAUGHAN

Surveyed October 17 & 18 1961 by *[Signature]*

1961 Q  
BBC-16N-163  
BBC-17N-141