


T.18S.R.40E.W.M.

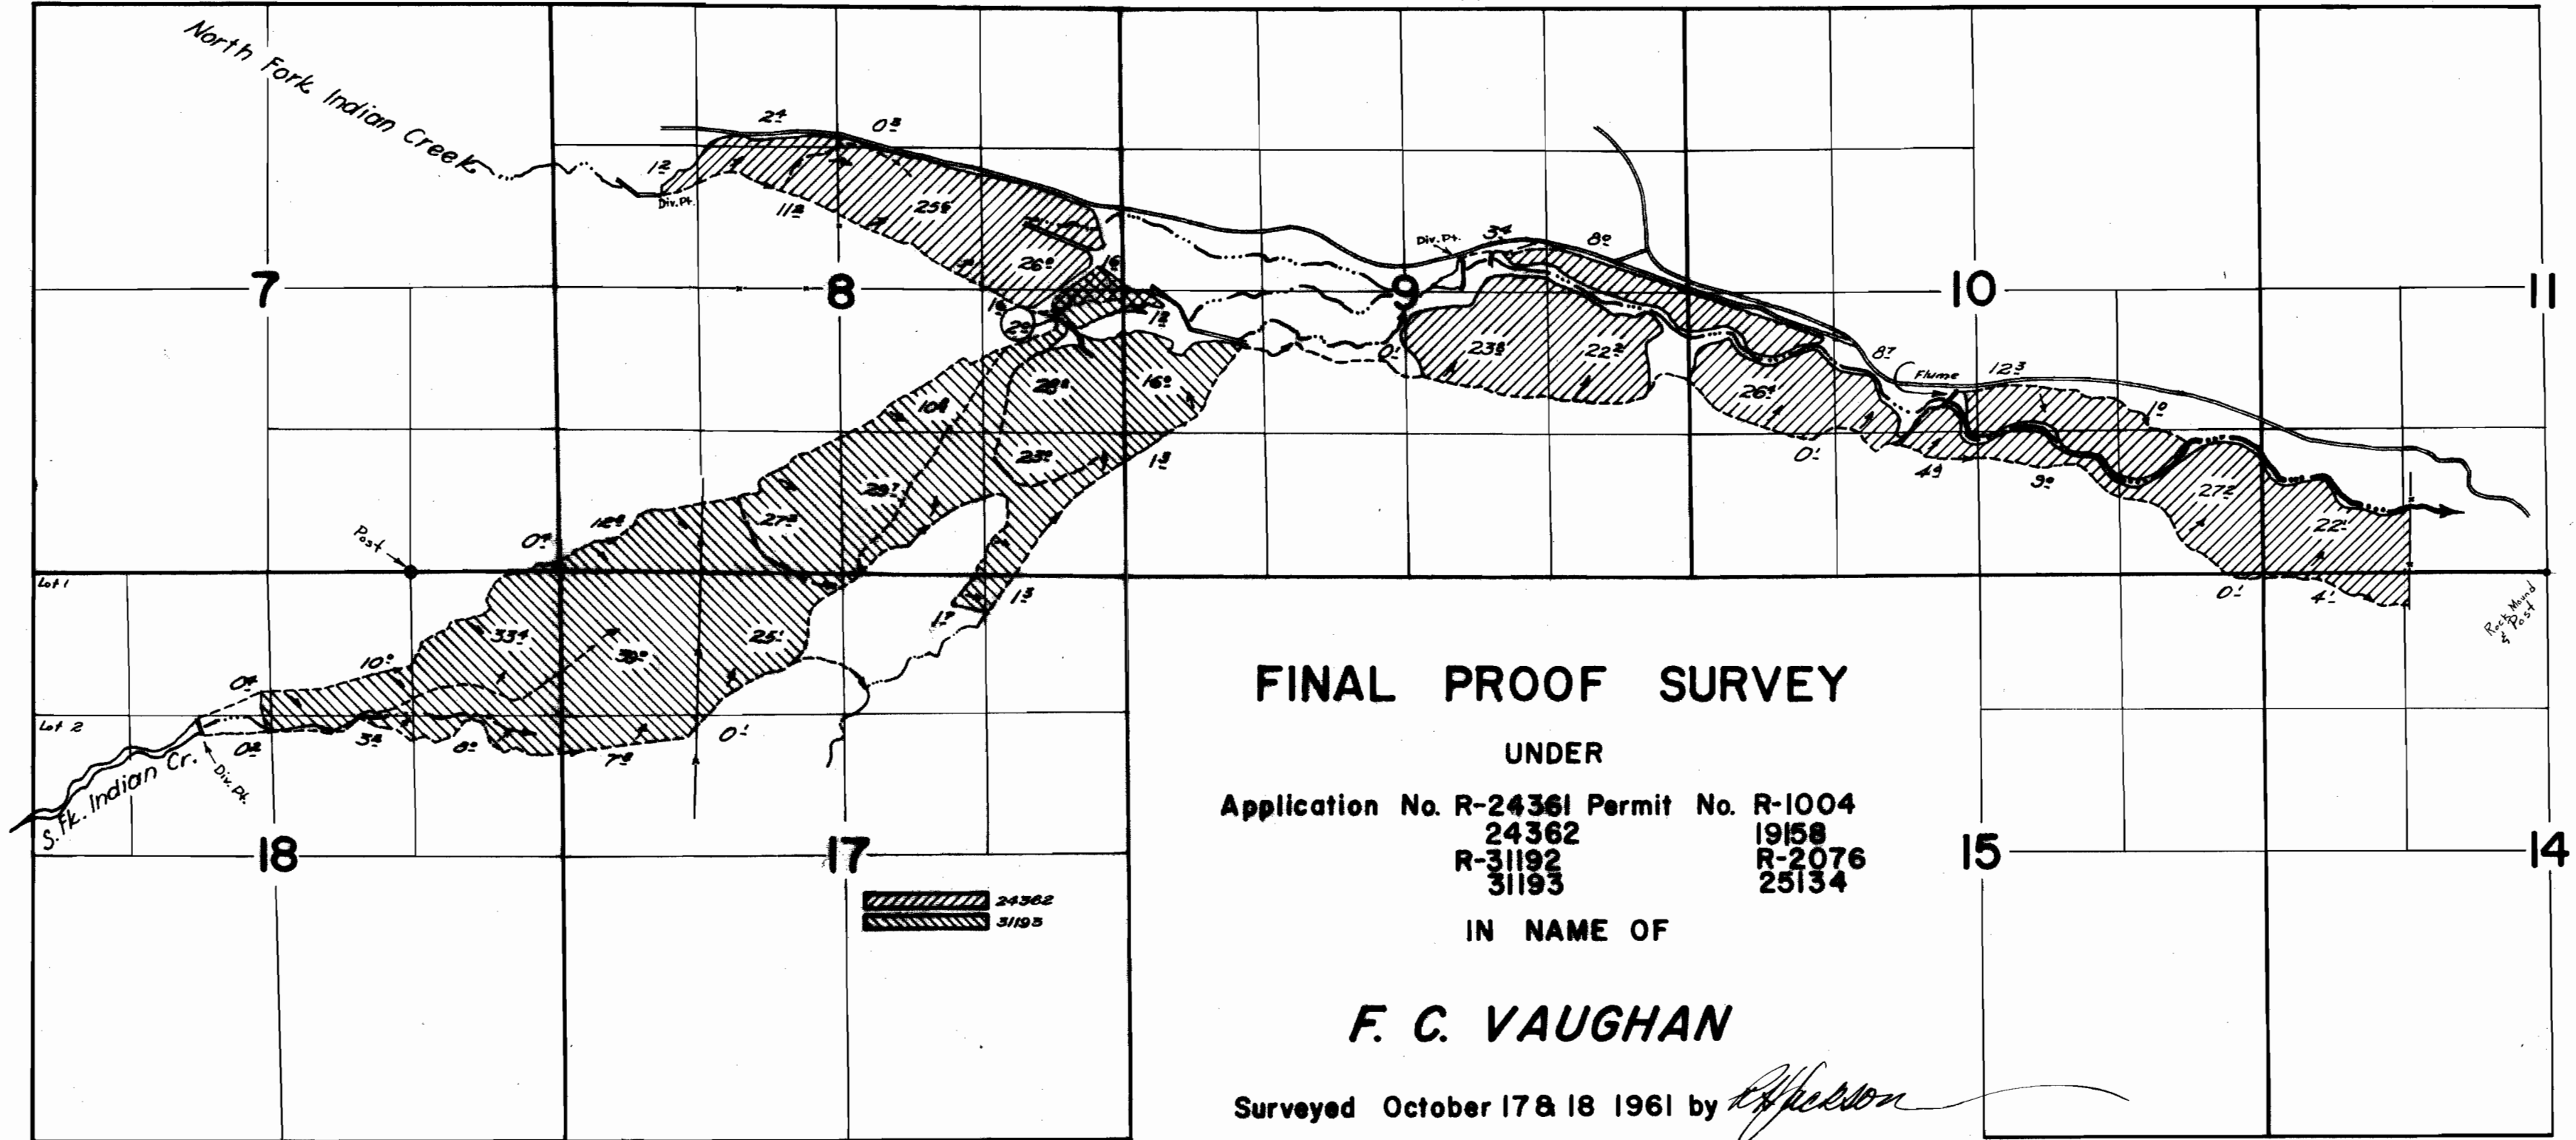

# FINAL PROOF SURVEY

UNDER

Application No. R-24361	Permit No. R-1004
24362	19158
R-31192	R-2076
31193	25134

IN NAME OF

## F. C. VAUGHAN

Surveyed October 17 & 18 1961 by *R. Johnson*

1961-G  
55C-16N-163  
55C-17N-141