


T.5 S.R.1 W.W.M.

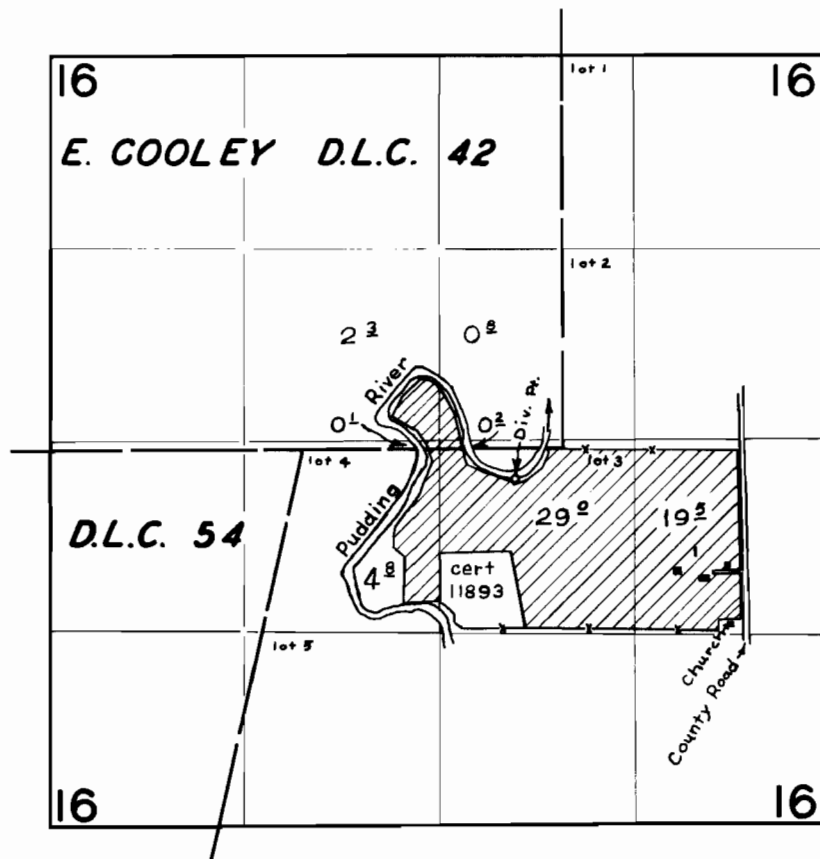

FINAL PROOF SURVEY
UNDER

Application No. 34845 Permit No. 27353
IN NAME OF

DAVID M. BOWMAN

Surveyed APR. 7 1964, by R. JACKSON