


T. 6 S. R. 1 W. W. M.

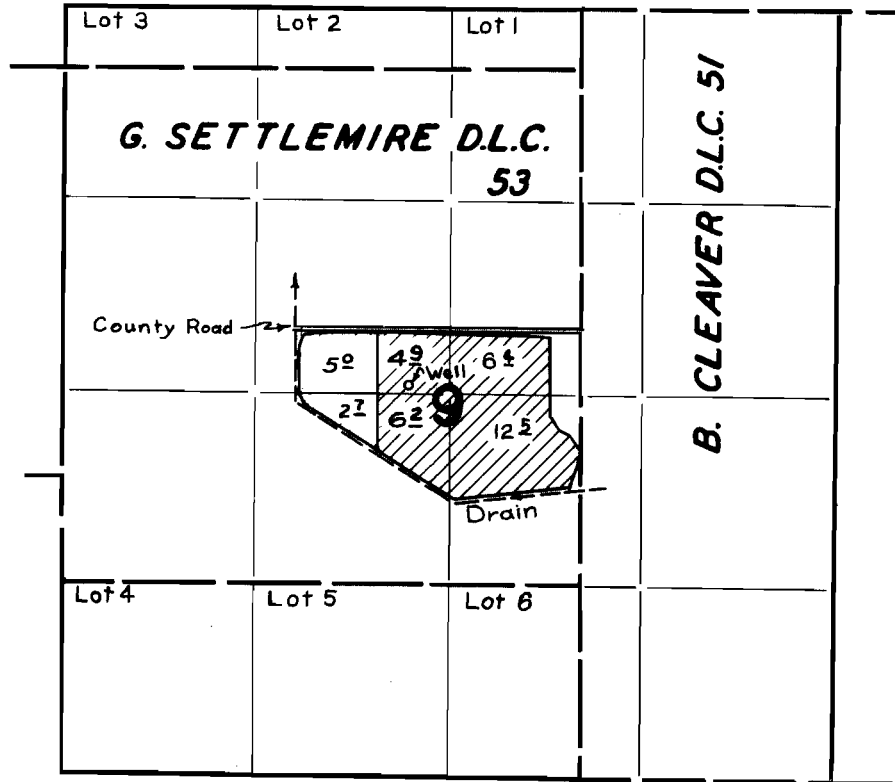

FINAL PROOF SURVEY UNDER

Application No. G-2308 Permit No. G-2196
IN NAME OF

CLEMENT J. EBNER

Surveyed JUN. 2, 1964, by R. JACKSON