


T. 7 S. R. 1 E. W. M.

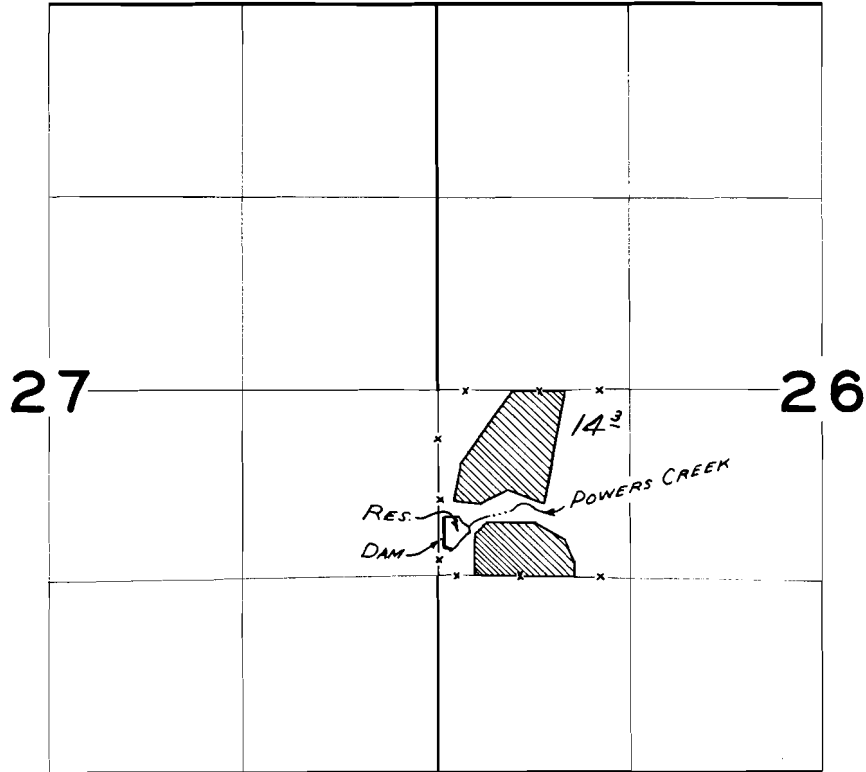

FINAL PROOF SURVEY
UNDER

Application No. R-37266 Permit No. R-2710
37267 27764
IN NAME OF

ENOS FETTERS

Surveyed JUL 13 1964, by R. JACKSON