


T. 7 S. R. 1 E. W. M.

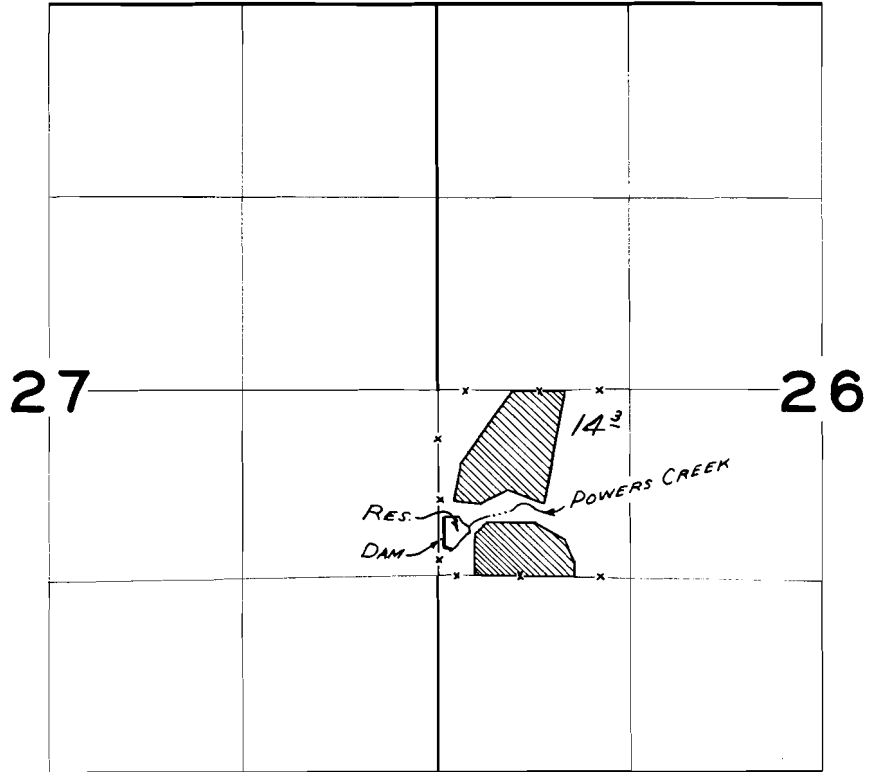

**FINAL PROOF SURVEY**  
UNDER

Application No. R-37266 Permit No. R-2710  
37267 27764  
IN NAME OF

ENOS FETTERS

Surveyed JUL 13 1964, by R. JACKSON