


T.8S. R.3W. W.M.

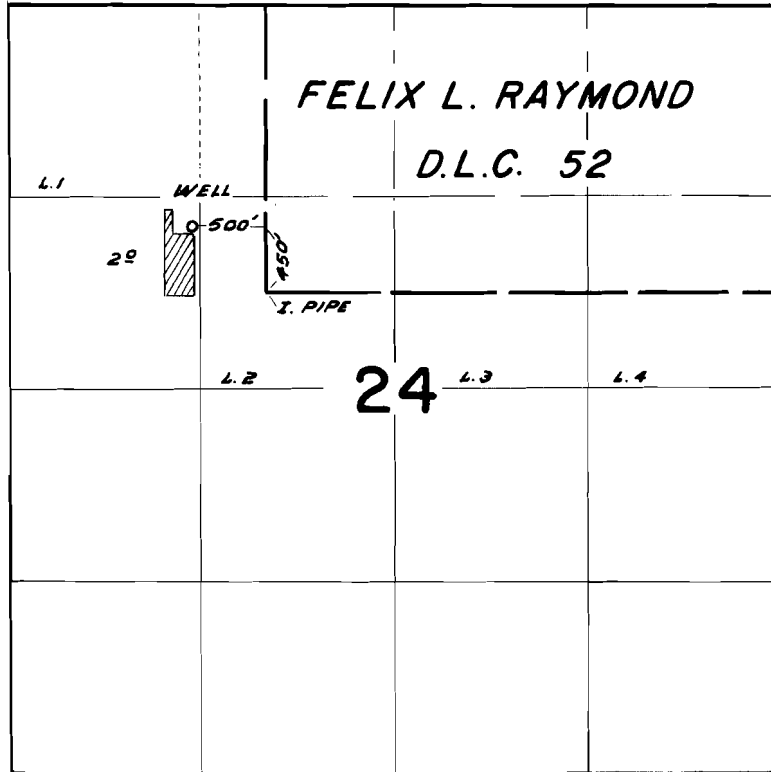

FINAL PROOF SURVEY
UNDER

Application No. 6-2970 Permit No. 6-2761
IN NAME OF

JACK J. KOCH

Surveyed JUNE 17 1965, by L. COLEBANK