


T. 8 S. R. 2 W. W. M.

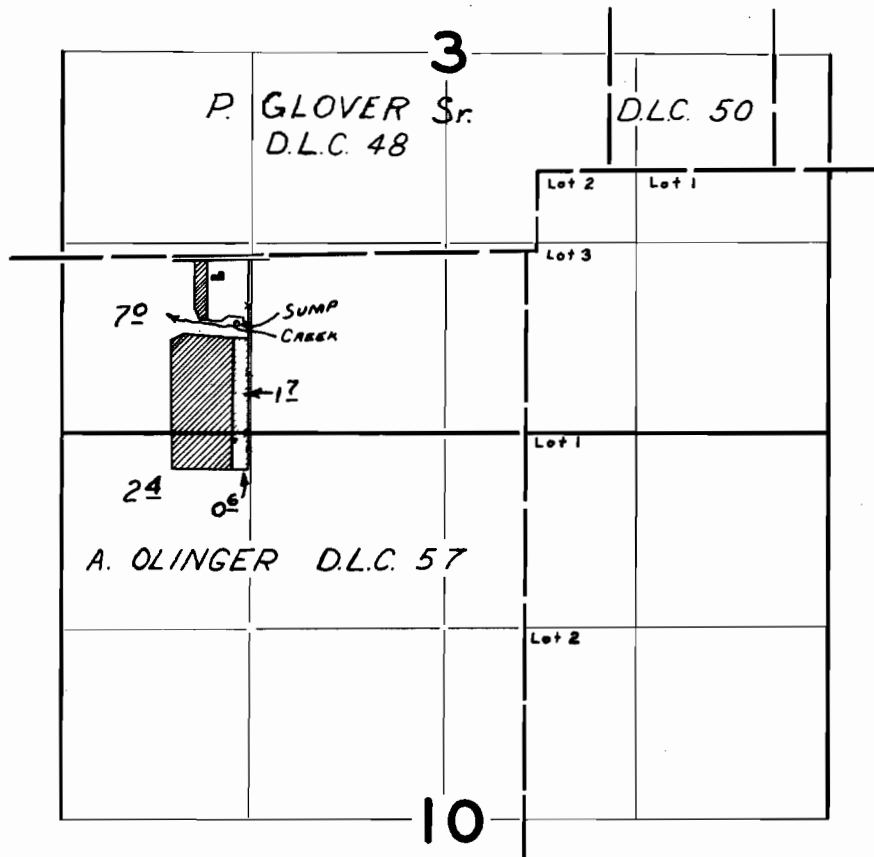

FINAL PROOF SURVEY UNDER

Application No. G-2657 Permit No. G-2464
IN NAME OF

ROBERT HARRIS

Surveyed Jul. 15 1964, by R. JACKSON