


T.5S.R.1W.W.M.

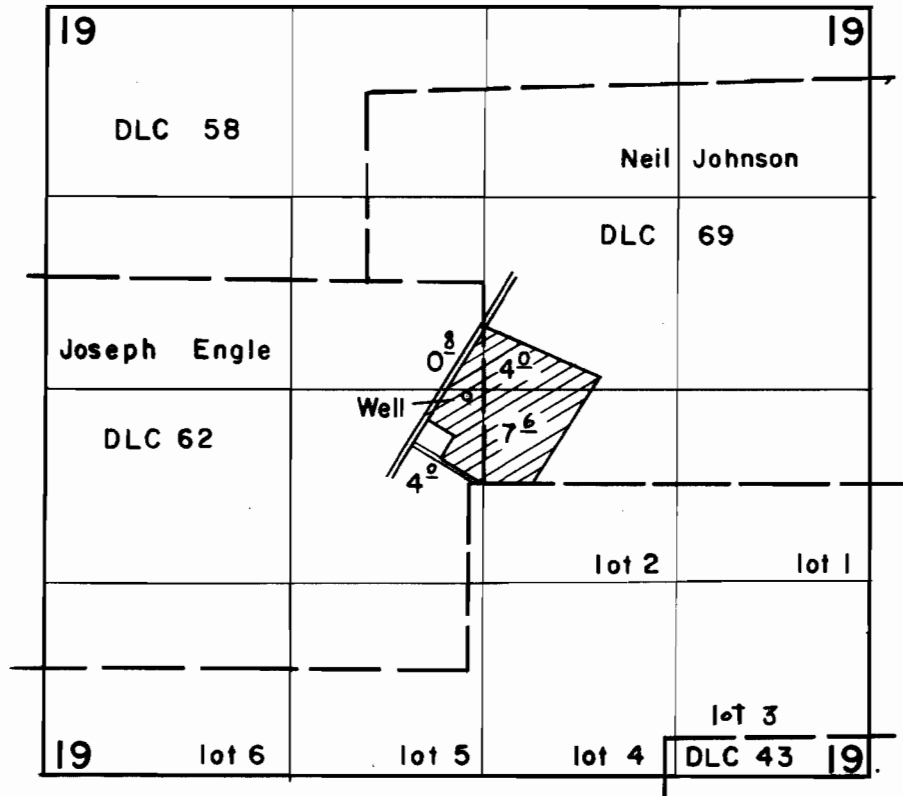

FINAL PROOF SURVEY UNDER

Application No. G-2322 Permit No. G-2148
IN NAME OF

William F. Leimbach Jr.

Inspected April 6, 1964, by R. Jackson