


T. 4 S. R. 3 W. W. M.

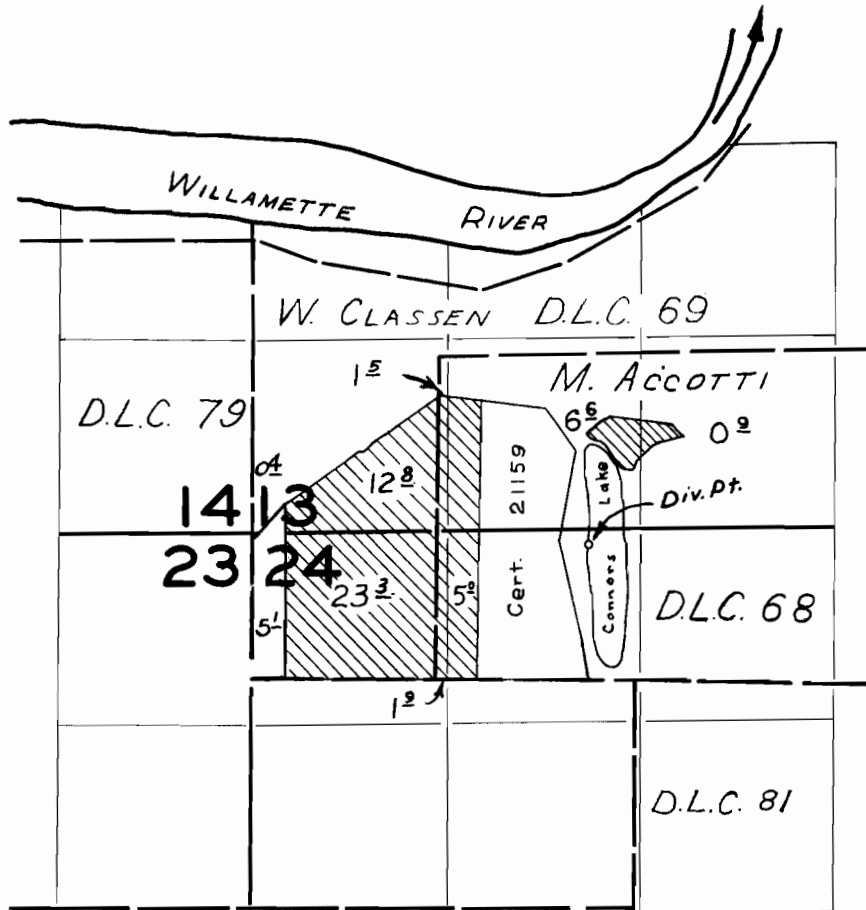

FINAL PROOF SURVEY
UNDER

Application No. 37249 Permit No. 27753
IN NAME OF

McKILLIP BROS.

Surveyed JUN. 26 1964, by R. JACKSON