


T.5 S.R. 1 W.W.M.

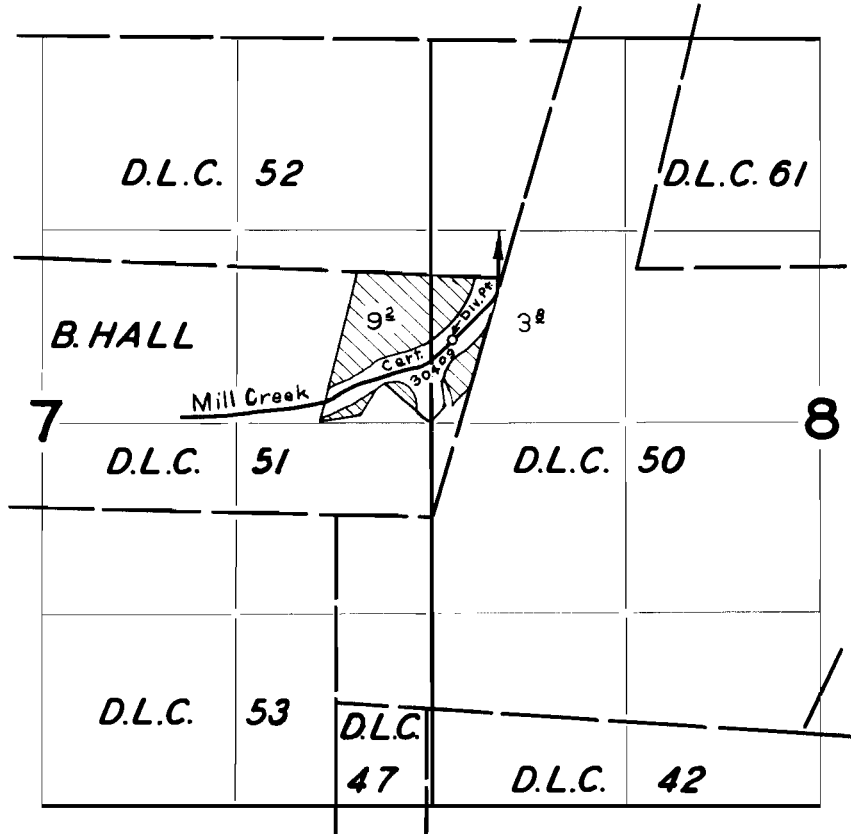

FINAL PROOF SURVEY
UNDER

Application No. 37119 Permit No. 27624
IN NAME OF

ROBERT B. MILLER

Surveyed APR. 7 1964, by R. JACKSON