


T. 5 S. R. 1 W. W. M.

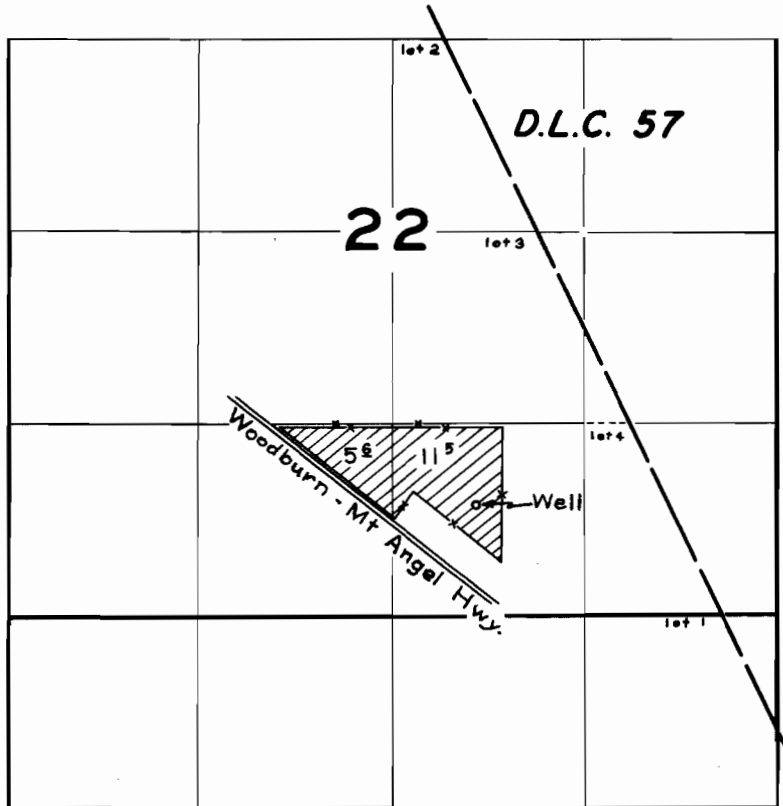

FINAL PROOF SURVEY
UNDER

Application No. G-2664 Permit No. G-2470
IN NAME OF

EDMOND E. NELSON

Surveyed APR 7 1964, by R. JACKSON